




as approved basement level in PA/00367/21 (unchanged)

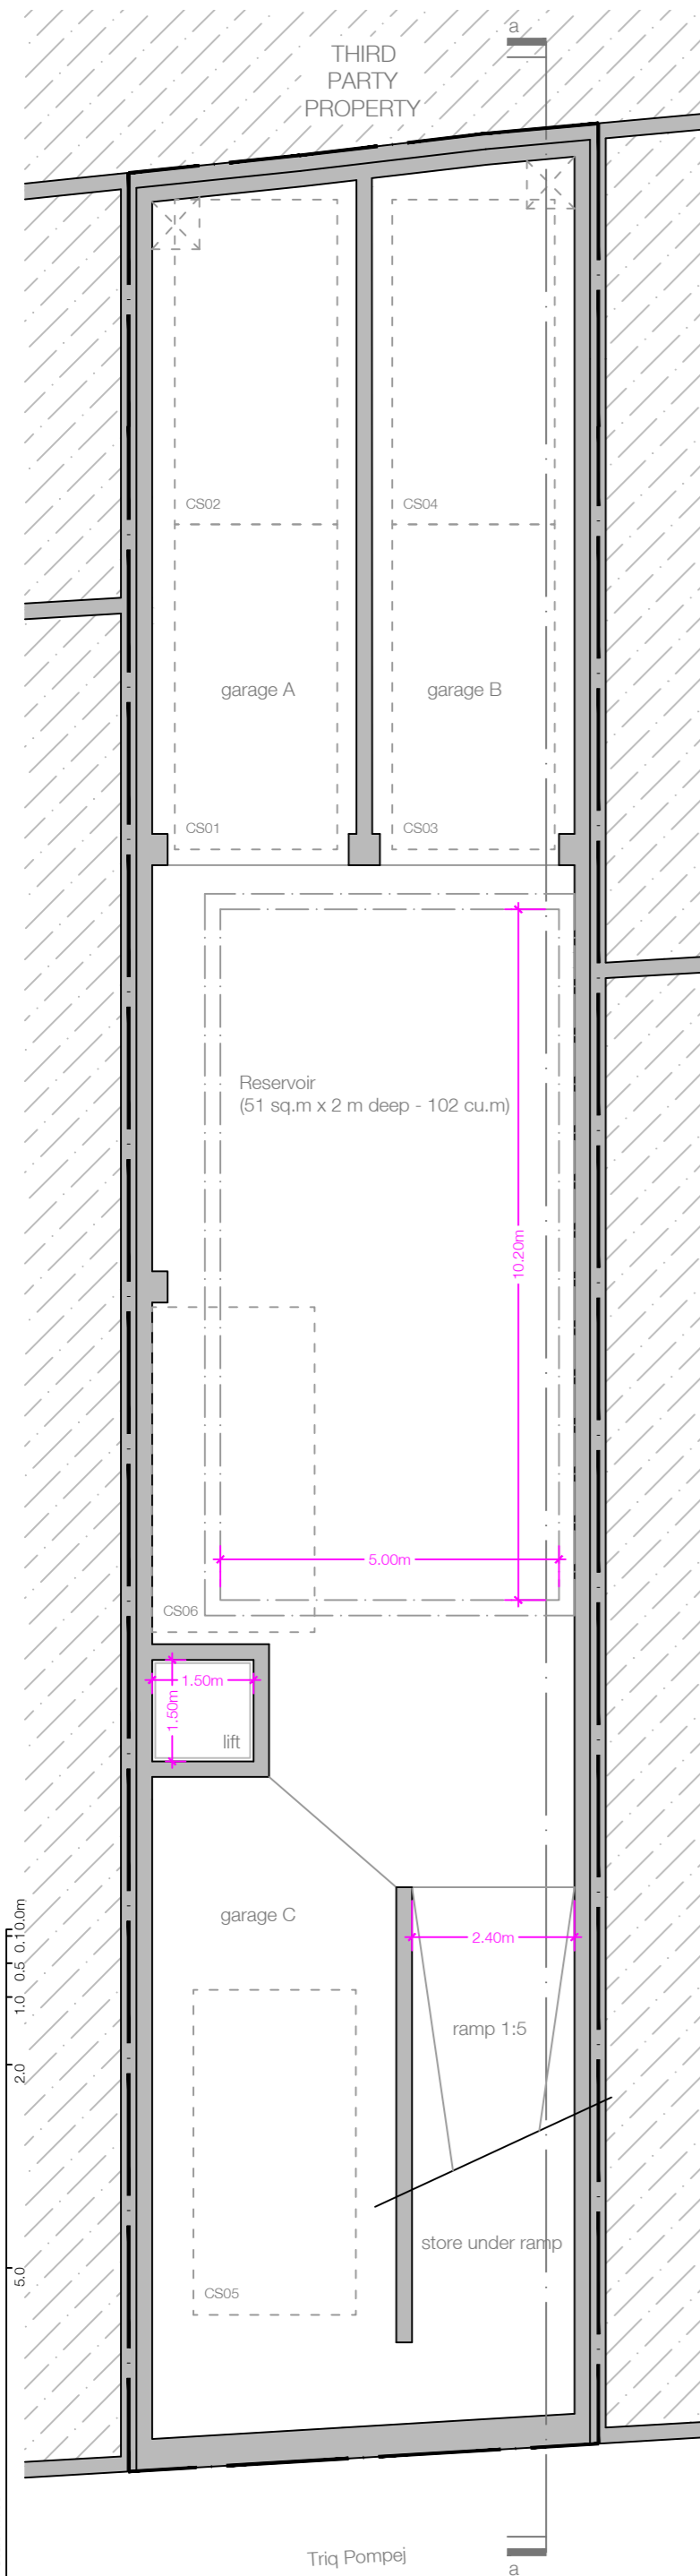


as approved ground floor level in PA/00367/21

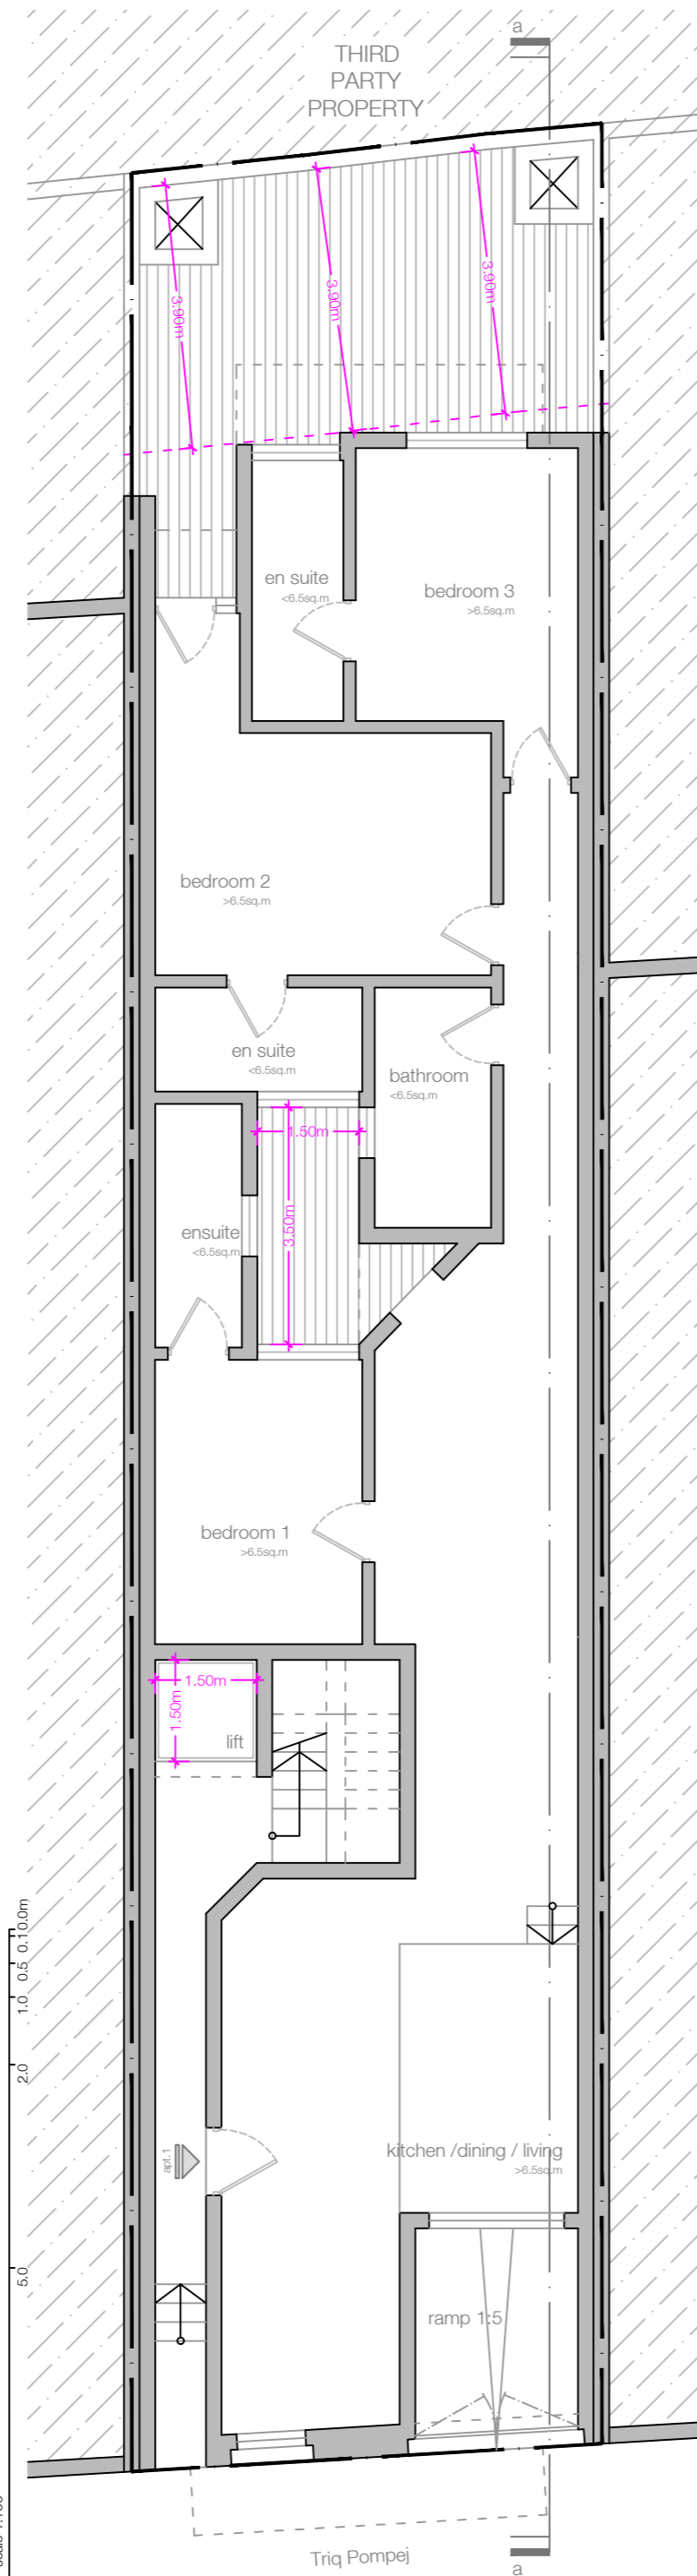

as proposed ground floor level (w/ changes)

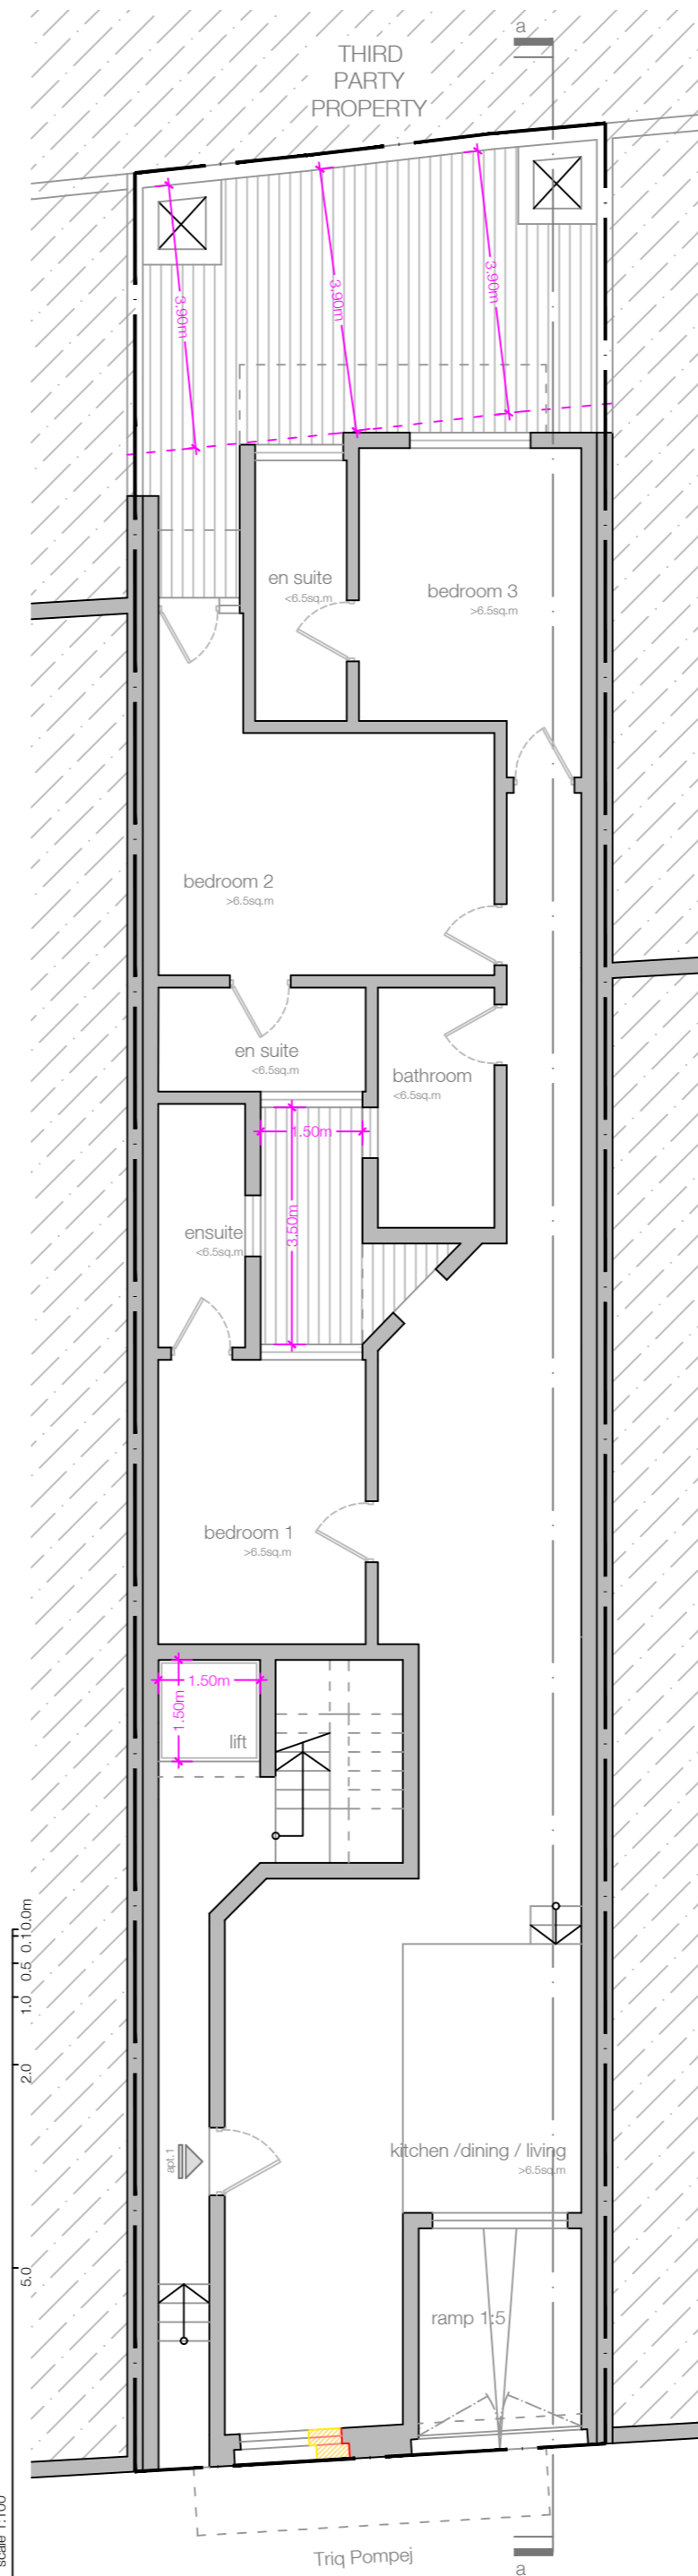

as proposed ground floor level

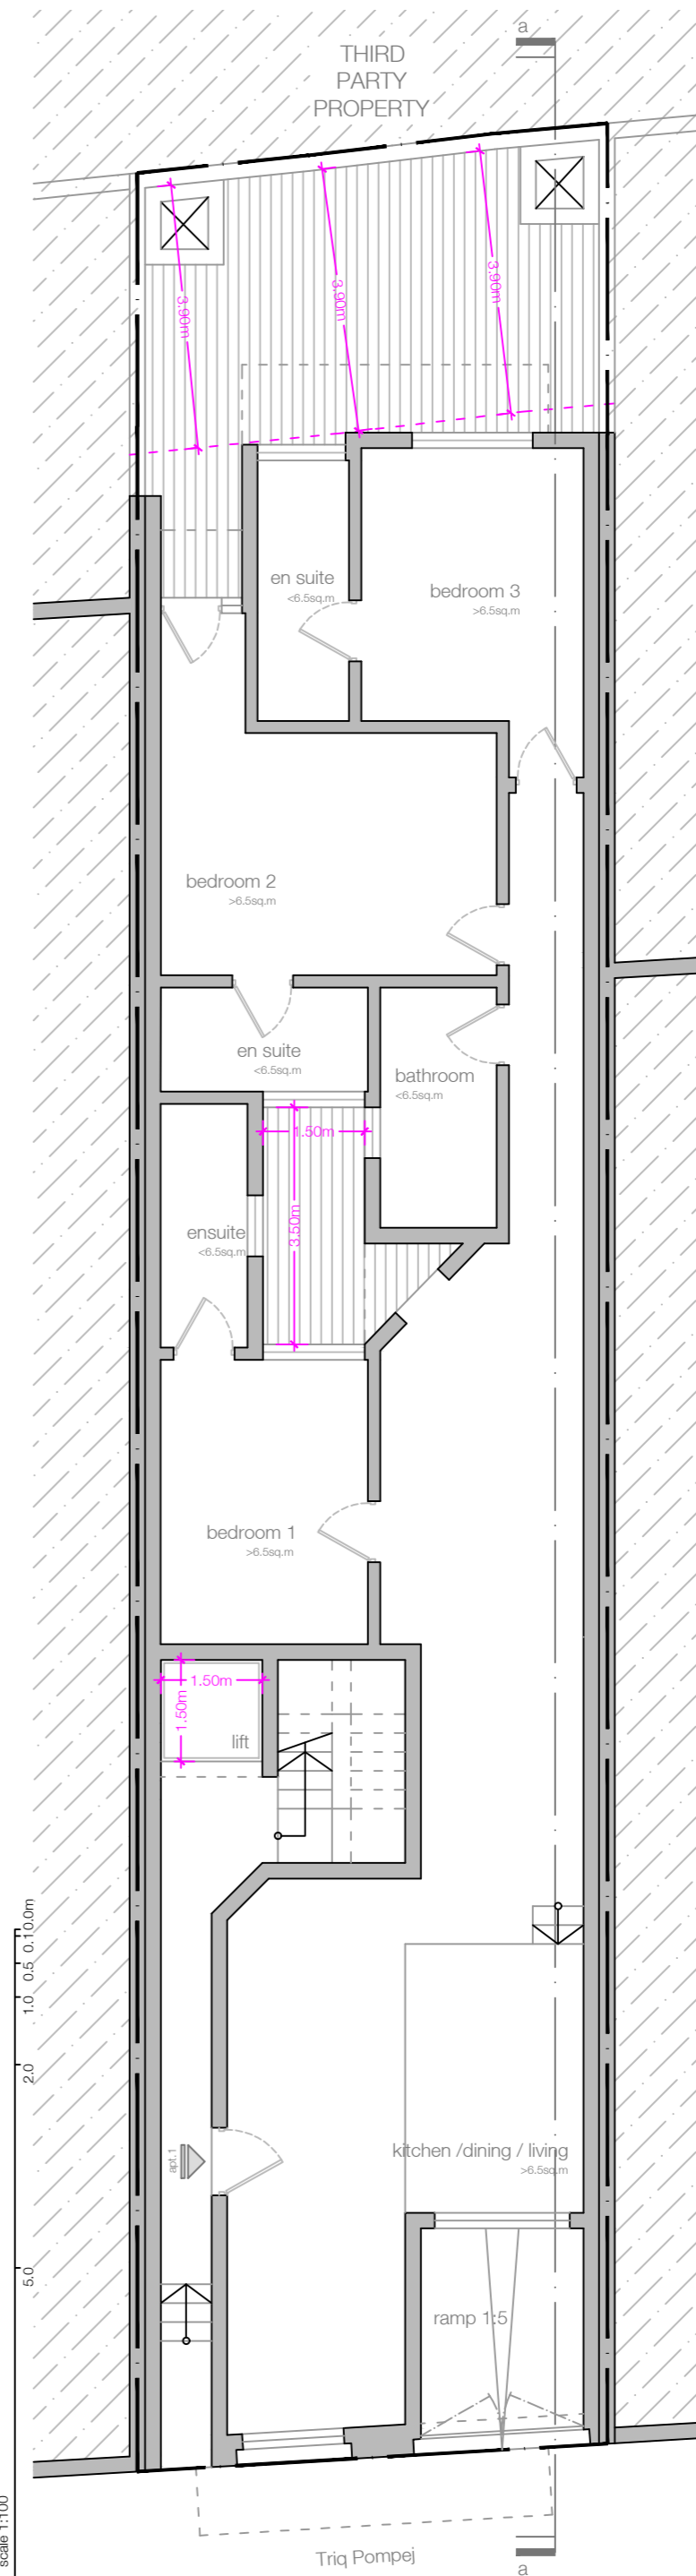

please note:
all dimensions are in mm unless otherwise stated. please do not scale off this drawing

All information and material illustrated on this document are subject to copyright owned by the ACT_N architects & civil engineers. Any reproduction, retransmission, equalisation, or other use of all or part of this document is expressly prohibited, unless prior written permission has been granted by ACT_N or the appropriate copyright owner. All other rights reserved.
Copyright © ACT_N architects and civil engineers. All rights reserved.

LEGEND	
■	to construct
■	to demolish
■	as approved but not constructed
■	to sanction: as built
	third party properties
	glass
	outdoor areas

drawing purpose		
<input checked="" type="checkbox"/>	design	
<input type="checkbox"/>	construction	
<input type="checkbox"/>	for information only	
rev. no.:	date:	description:
---	---/---/---	---


ACT_N
architects + civil engineers
90 / ACT_N studio, ganu street, birikikara, BKR1105, malta
t: +356 21318184 www.actn-studio.com
f: @ACTNace p.no.: P/19

perit **CHARLES AZZOPARDI**
A.C.E., B.E.SA (hons)
e: c.azzopardi@actn-studio.com m: +356 99292993
warrant number: 680


perit **DORIANNE ELLIS**
M.Sc. (Struct. Eng.) (Surv), A.C.E., B.E.SA (hons)
e: d.ellis@actn-studio.com m: +356 99269125
warrant number: 658

client:	ms. anne ellis
description:	amendments to PA/00367/21, extension of second floor level and construction of a third recessed floor at vacant site in Triq Pompej, Victoria
location:	victoria, gozo
drawing title:	basement level to ground floor level
scale:	1:100 @ A2
date:	2021/09/22
reference:	VCT.AE.01
dwg. no.:	001
revision no.:	R00
PA no.:	---/---/---
drawn by:	V.C.


as approved first floor level in PA/00367/21

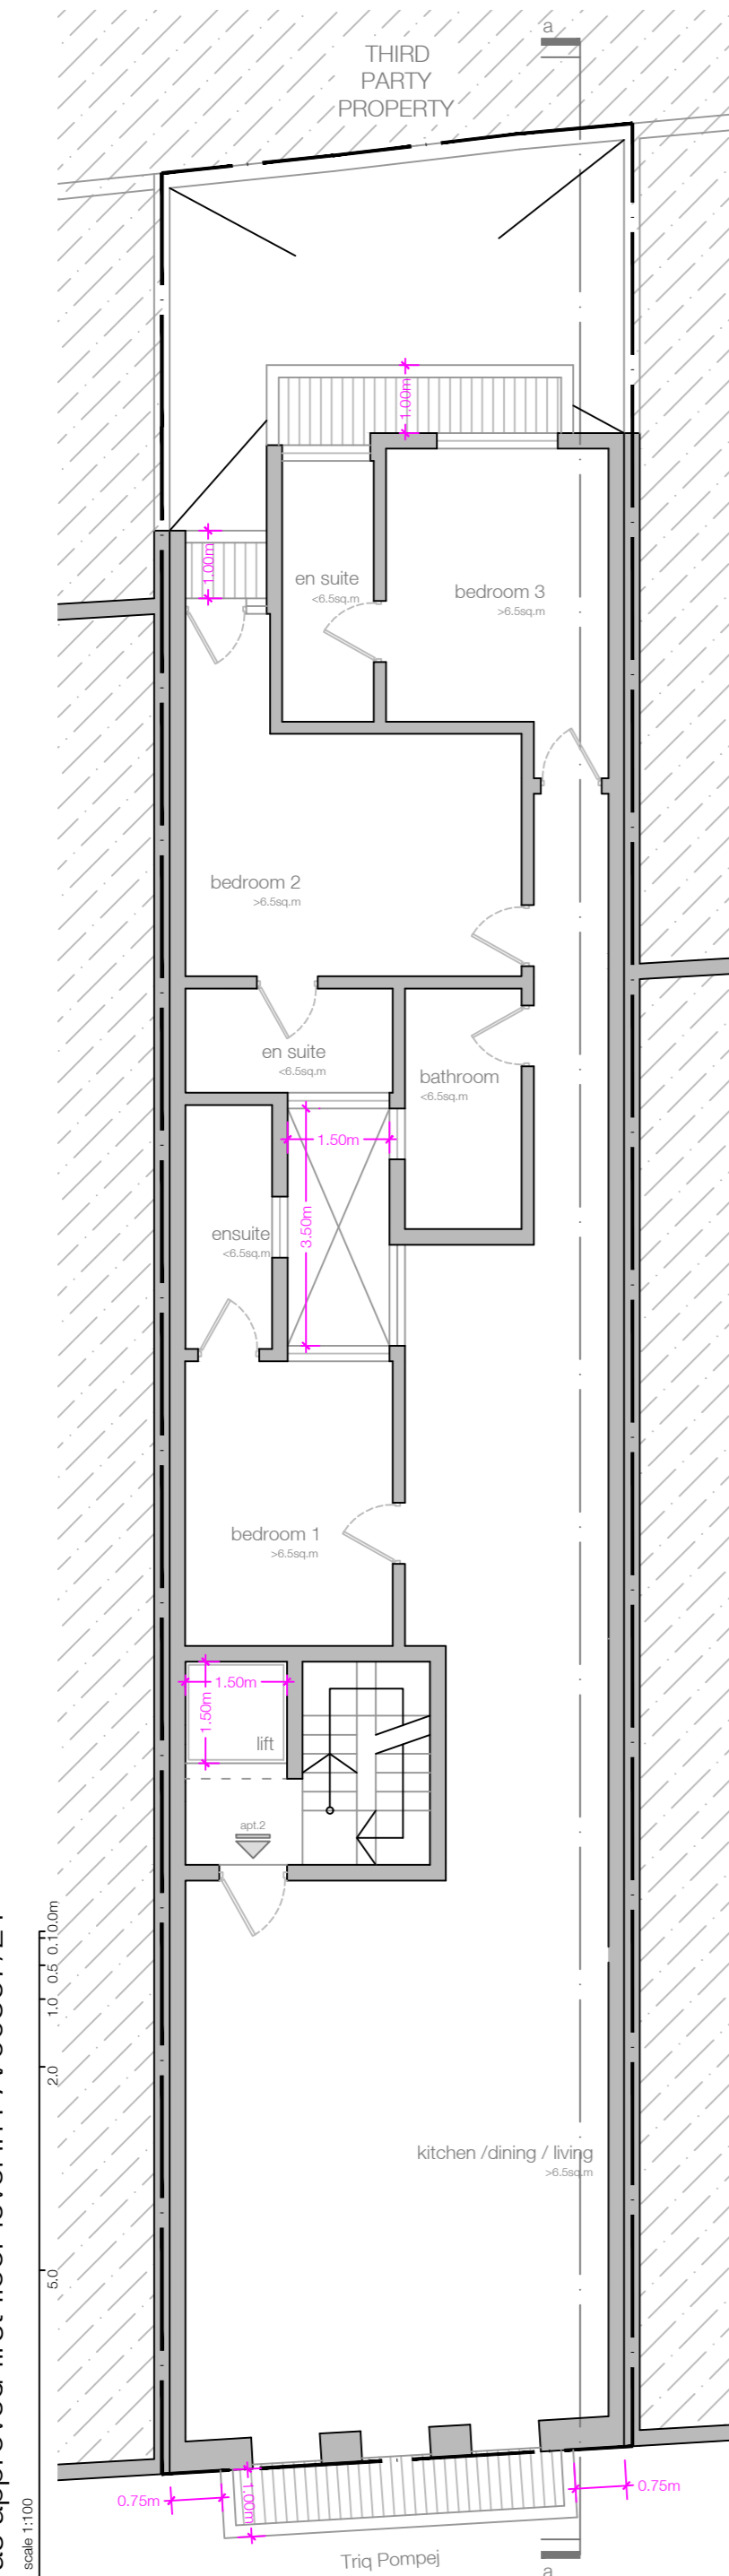

as proposed first floor level (w/ changes)

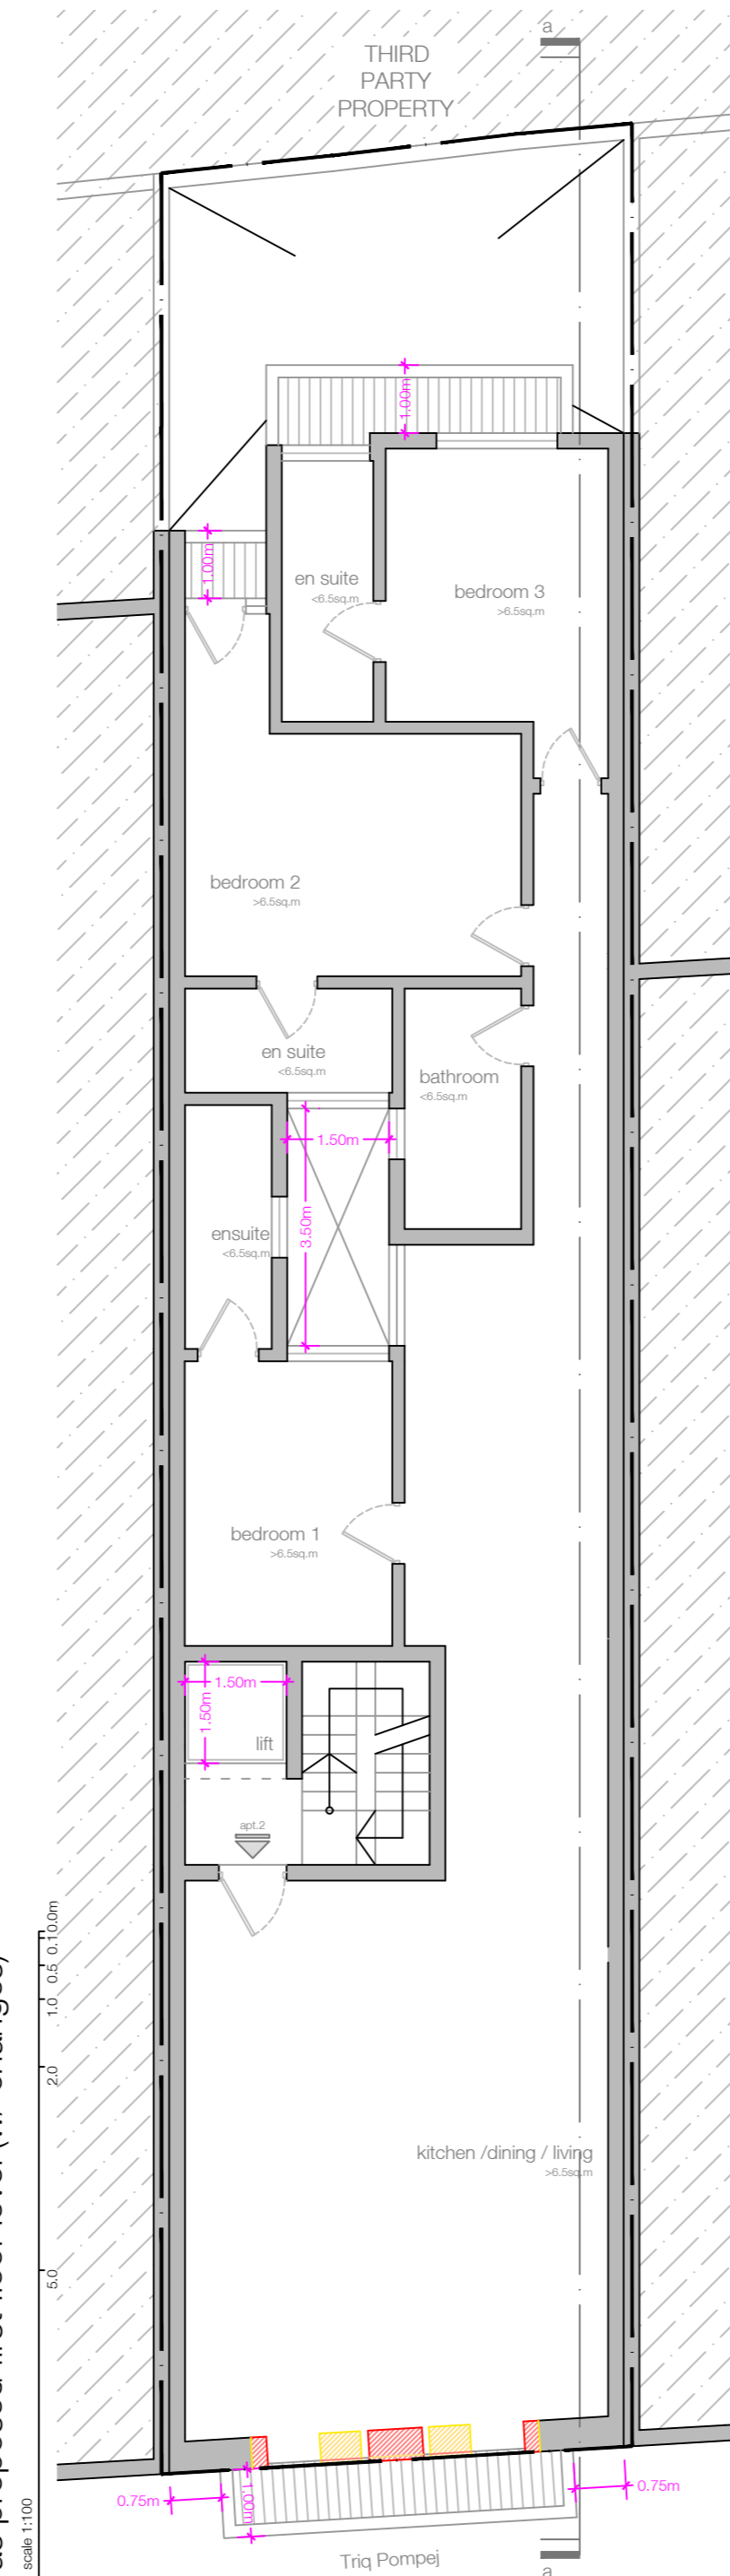

as proposed first floor level

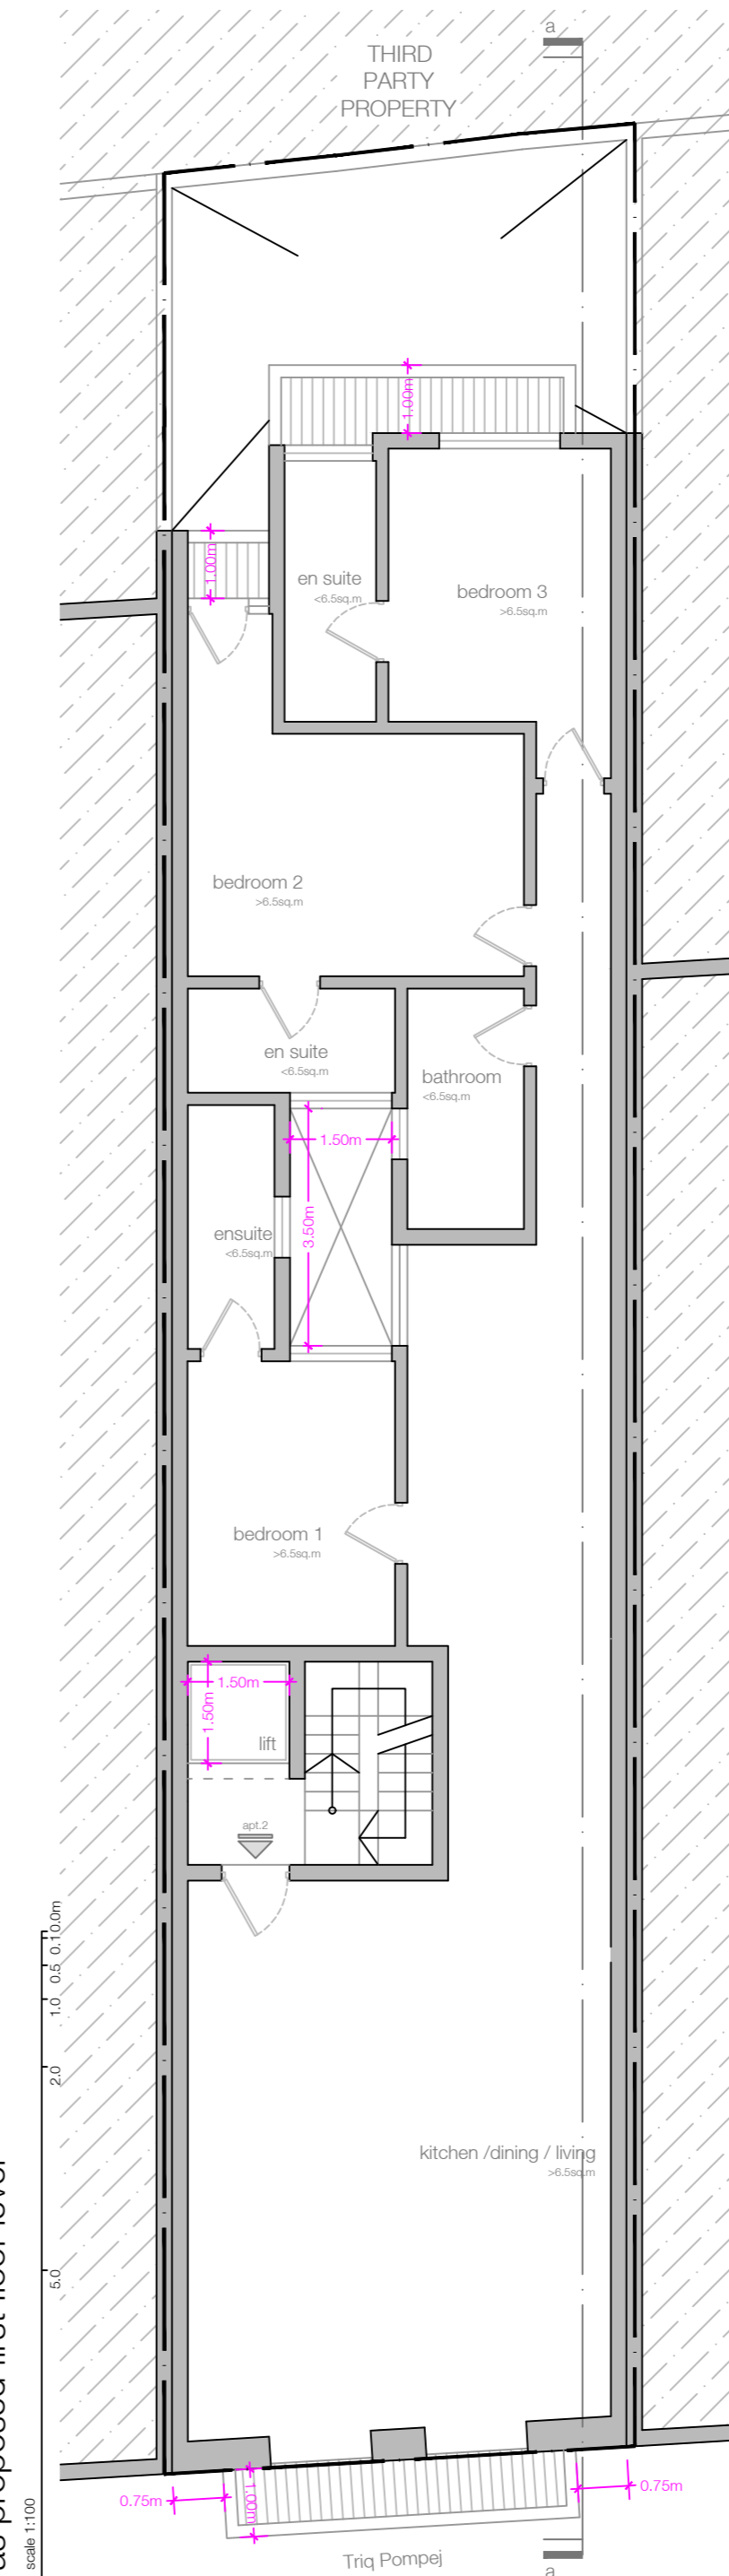

please note:
all dimensions are in mm unless otherwise stated. please do not scale off this drawing

All information and material illustrated on this document are subject to copyright owned by the ACT_N architects & civil engineers. Any reproduction, retransmission, equalisation, or other use of all or part of this document is expressly prohibited, unless prior written permission has been granted by ACT_N or the appropriate copyright owner. All other rights reserved.

Copyright © ACT_N architects and civil engineers. All rights reserved.

LEGEND

■	to construct	■	to demolish
■	as approved but not constructed	■	to sanction: as built
	third party properties		
	glass		
	outdoor areas		

drawing purpose

<input type="checkbox"/>	design
<input type="checkbox"/>	construction
<input type="checkbox"/>	for information only

rev. no.: date: description:

ACT_N
architects + civil engineers

90 / ACT_N studio, ganu street, birikikara, BKR1105, malta
t: +356 21318184 www.actn-studio.com
f: @ACTNace p.no.: P/19

perit CHARLES AZZOPARDI
A.C.E., B.E.SA (hons)
e: c.azzopardi@actn-studio.com m: +356 99292993
warrant number: 680

perit DORIANNE ELLIS
M.Sc. (Struct. Eng) (Surv), A.C.E., B.E.SA (hons)
e: d.ellis@actn-studio.com m: +356 9929125
warrant number: 658

client: ms. anne ellis

description: amendments to PA/00367/21, extension of second floor level and construction of a third recessed floor at vacant site in Triq Pompej, Victoria


location: victoria, gozo

drawing title: as approved / as proposed first floor level


scale: 1:100 @ A2	dwg. no.: 002	revision no.: R00
date: 2021/09/22	PA no.: -/-/-/-/-	drawn by: V.C.

reference: VCT.AE.01


as approved second floor level in PA/00367/21
scale 1:100

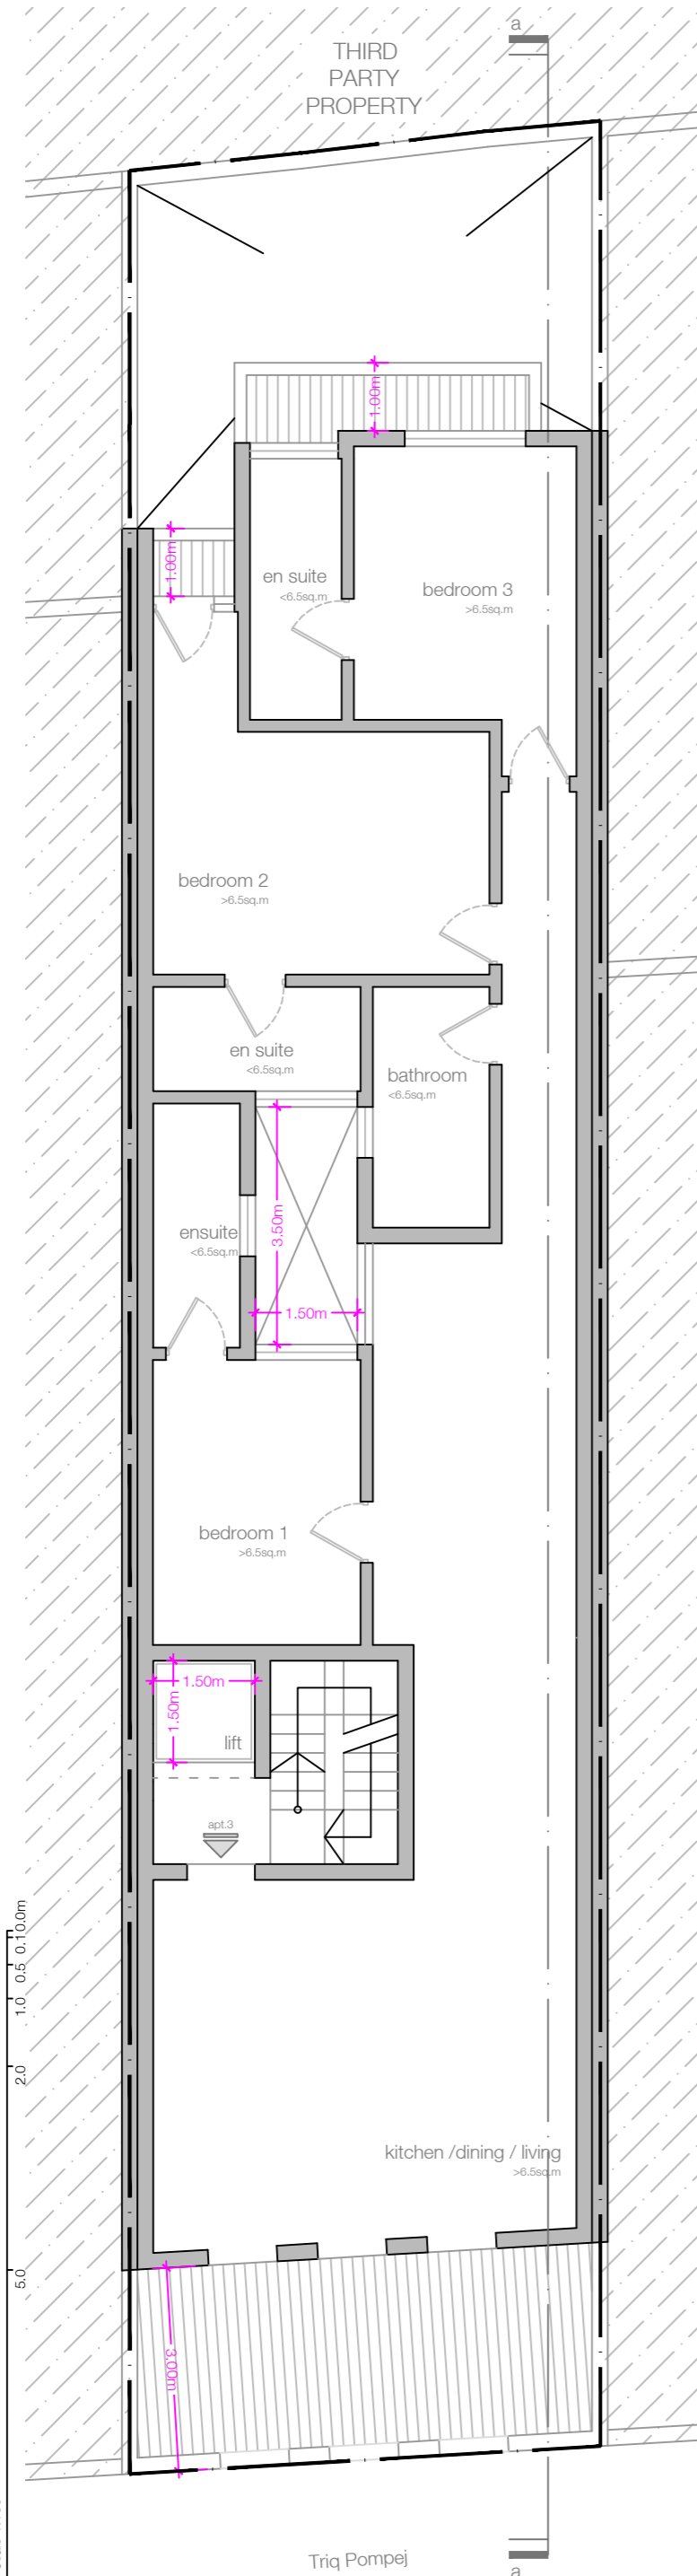

as proposed second floor level (w/ changes)
scale 1:100

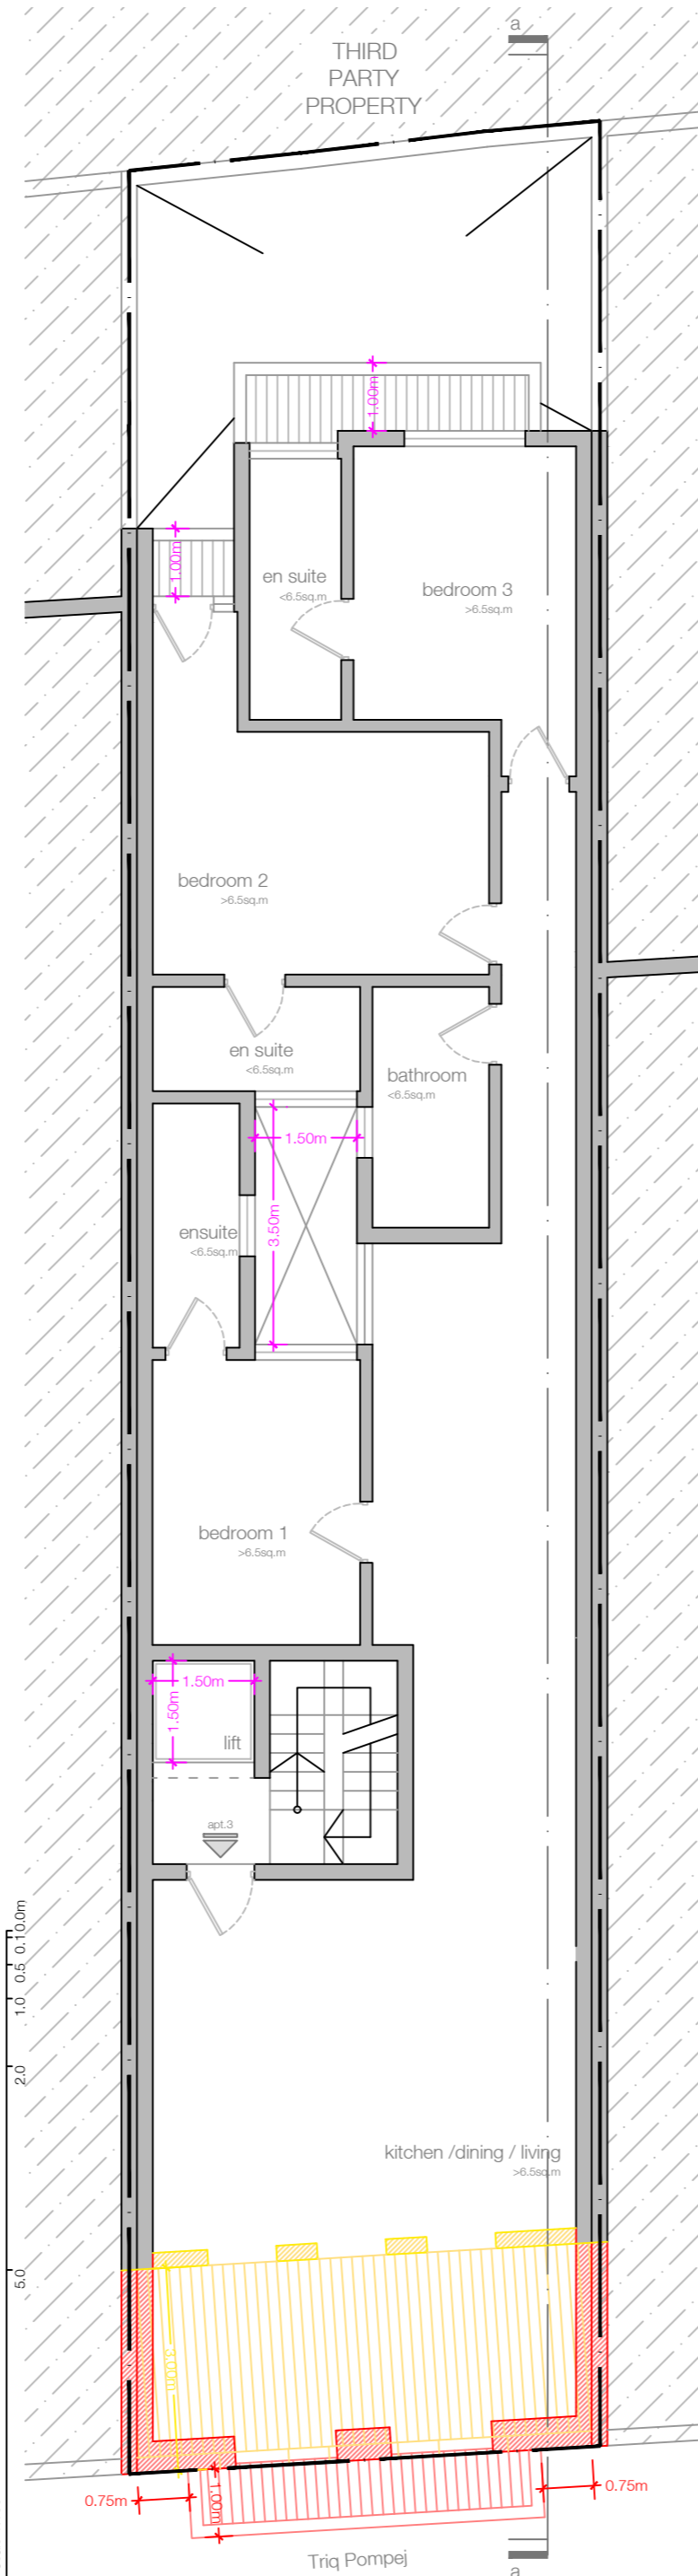

as proposed second floor level
scale 1:100

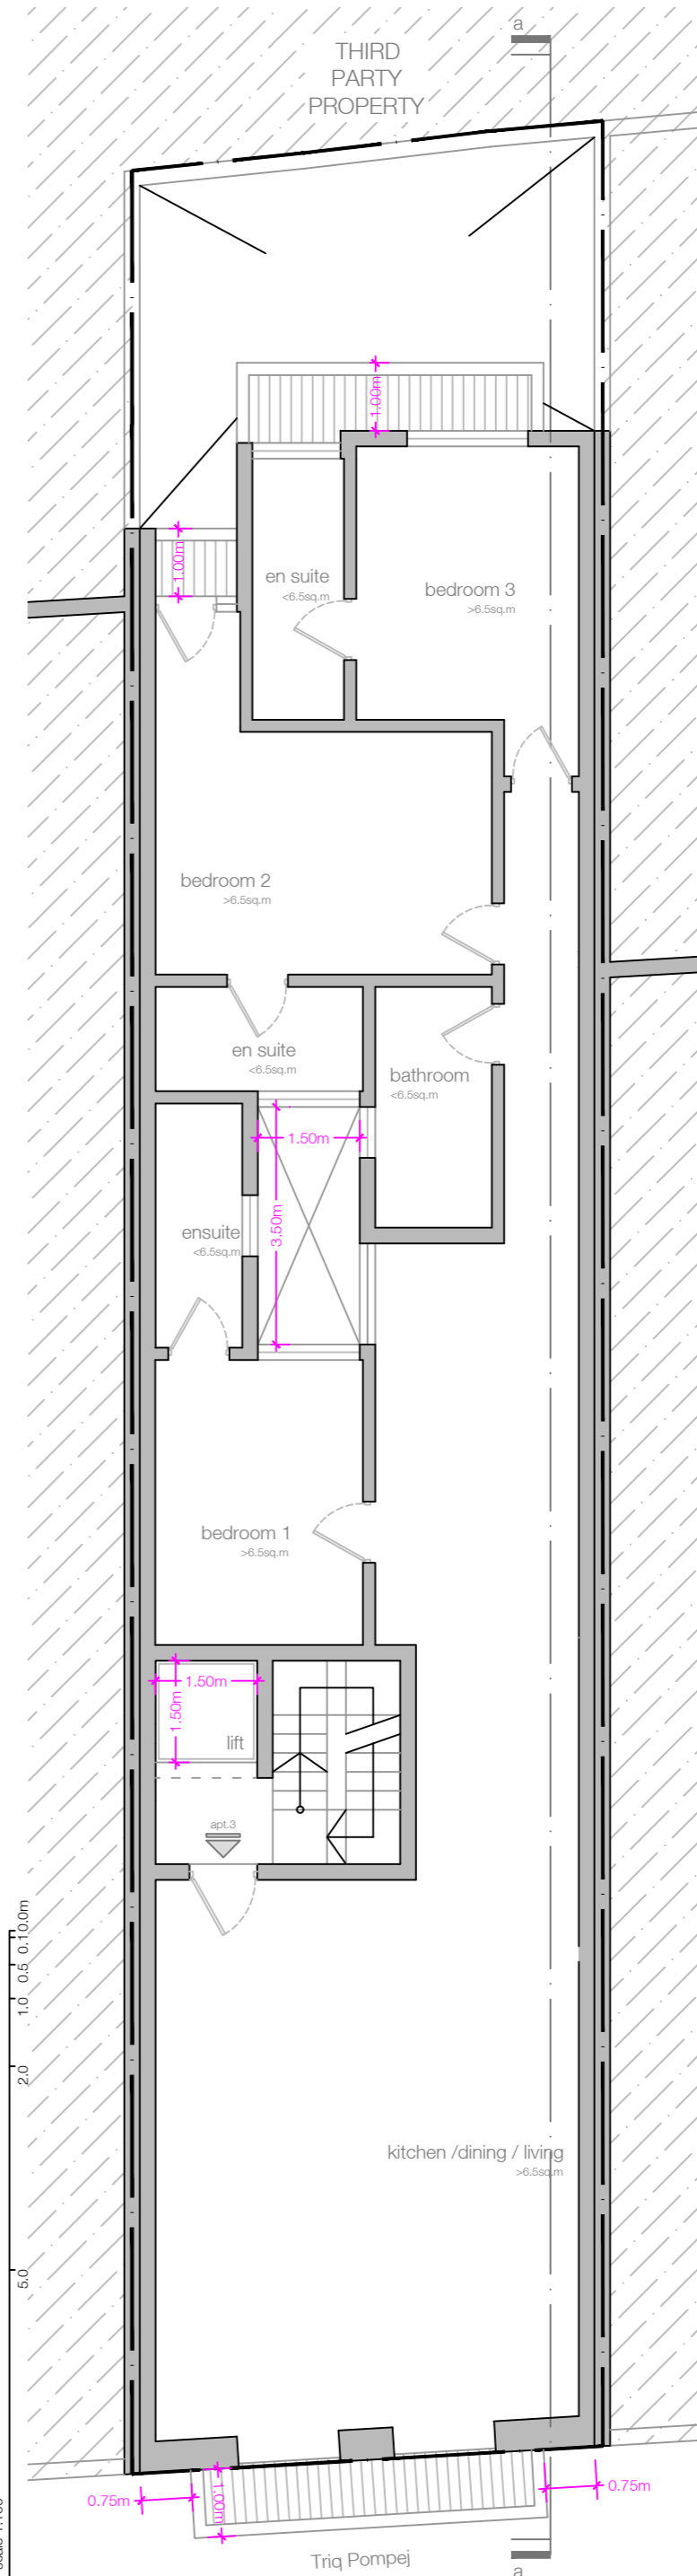

please note:
all dimensions are in mm unless otherwise stated. please do not scale off this drawing

All information and material illustrated on this document are subject to copyright owned by the ACT_N architects & civil engineers. Any reproduction, retransmission, equalisation, or other use of all or part of this document is expressly prohibited, unless prior written permission has been granted by ACT_N or the appropriate copyright owner. All other rights reserved.

Copyright © ACT_N architects and civil engineers. All rights reserved.

LEGEND

█	to construct	█	to demolish
█	as approved but not constructed	█	to sanction: as built
	third party properties		
	glass		
	outdoor areas		

drawing purpose

<input checked="" type="checkbox"/>	design
<input type="checkbox"/>	construction
<input type="checkbox"/>	for information only

rev. no.: date: description:

---	---/---/---	---

ACT_N
architects + civil engineers

90 / ACT_N studio, ganu street, birikikara, BKR1105, malta
t: +356 21318184 www.actn-studio.com
f: @ACTNace p.no.: P/19

perit CHARLES AZZOPARDI
A.C.E., B.E.SA (hons)
e: c.azzopardi@actn-studio.com m: +356 99292993
warrant number: 680

perit DORIANNE ELLIS
M.Sc. (Struct. Eng.) (Surv.), A.C.E., B.E.SA (hons)
e: d.ellis@actn-studio.com m: +356 99299125
warrant number: 658

client: ms. anne ellis

description: amendments to PA/00367/21, extension of second floor level and construction of a third recessed floor at vacant site in Triq Pompej, Victoria


location: victoria, gozo

drawing title: as approved / as proposed second floor level


scale:	1:100 @ A2	dwg. no.:	003	revision no.:	R00
date:	2021/09/22	PA no.:	---/---/---	drawn by:	V.C.

reference: VCT.AE.01


as approved receded floor level in PA/00367/21

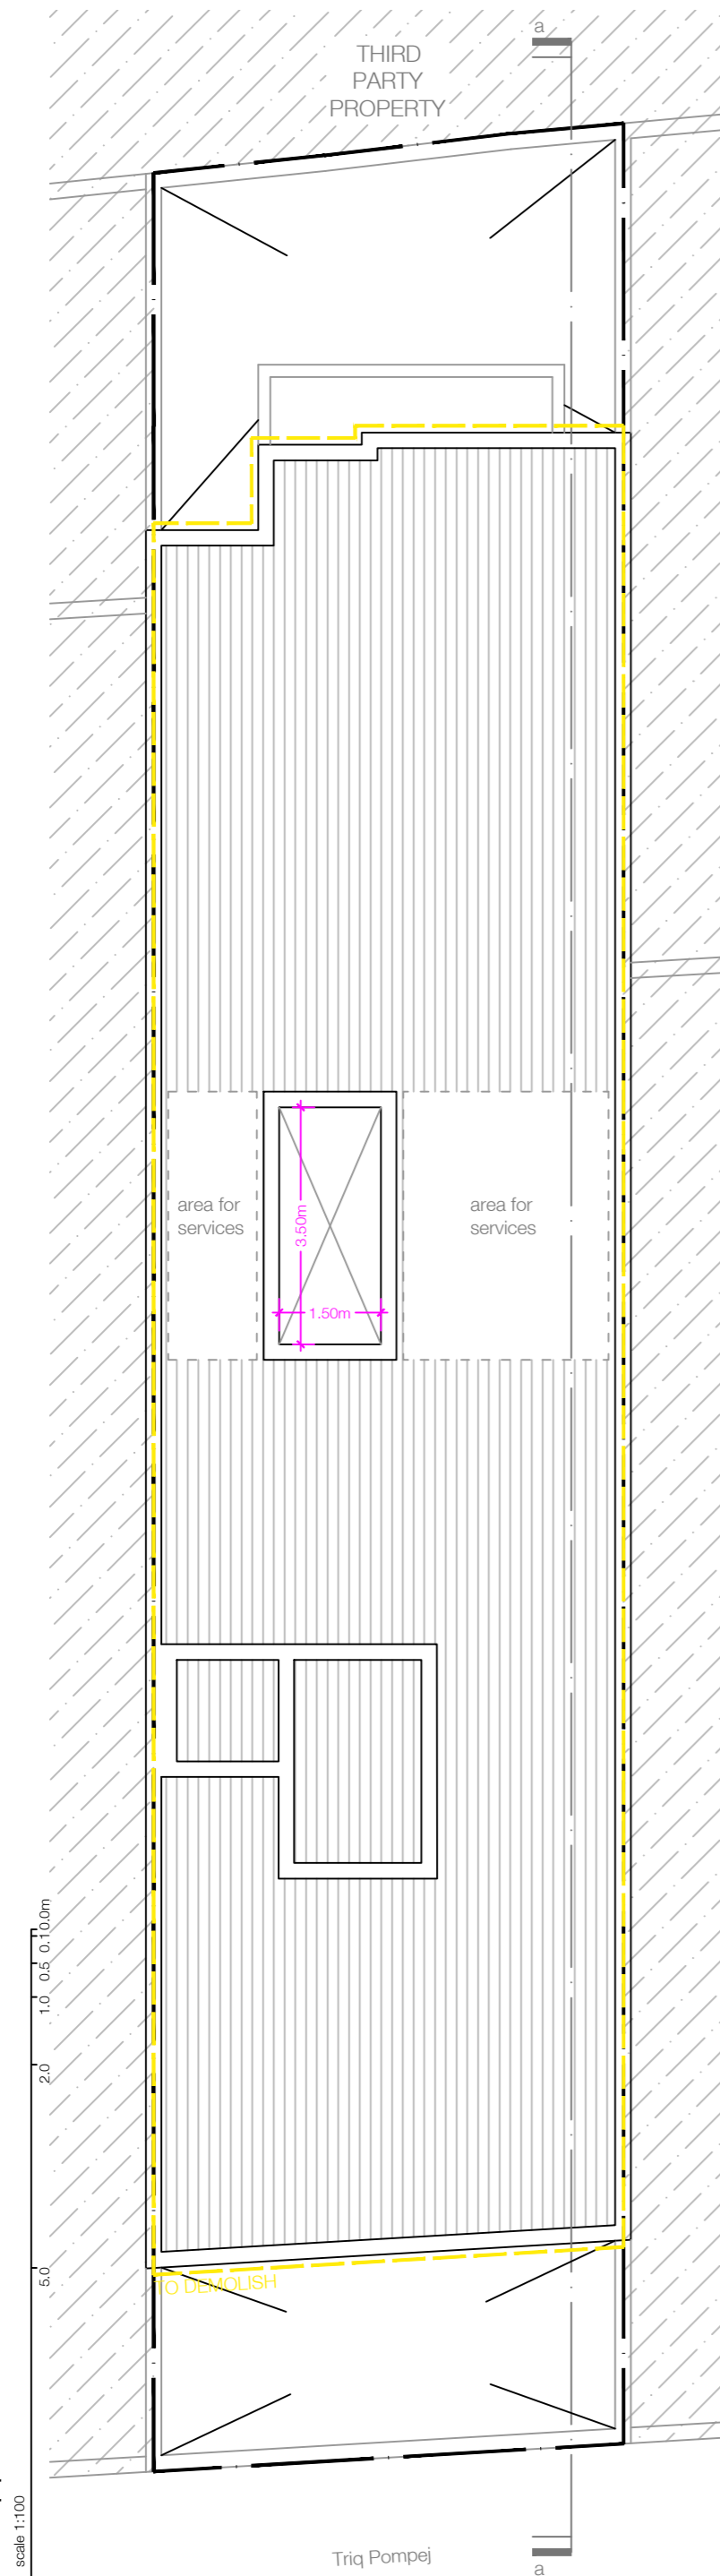

as proposed receded floor level

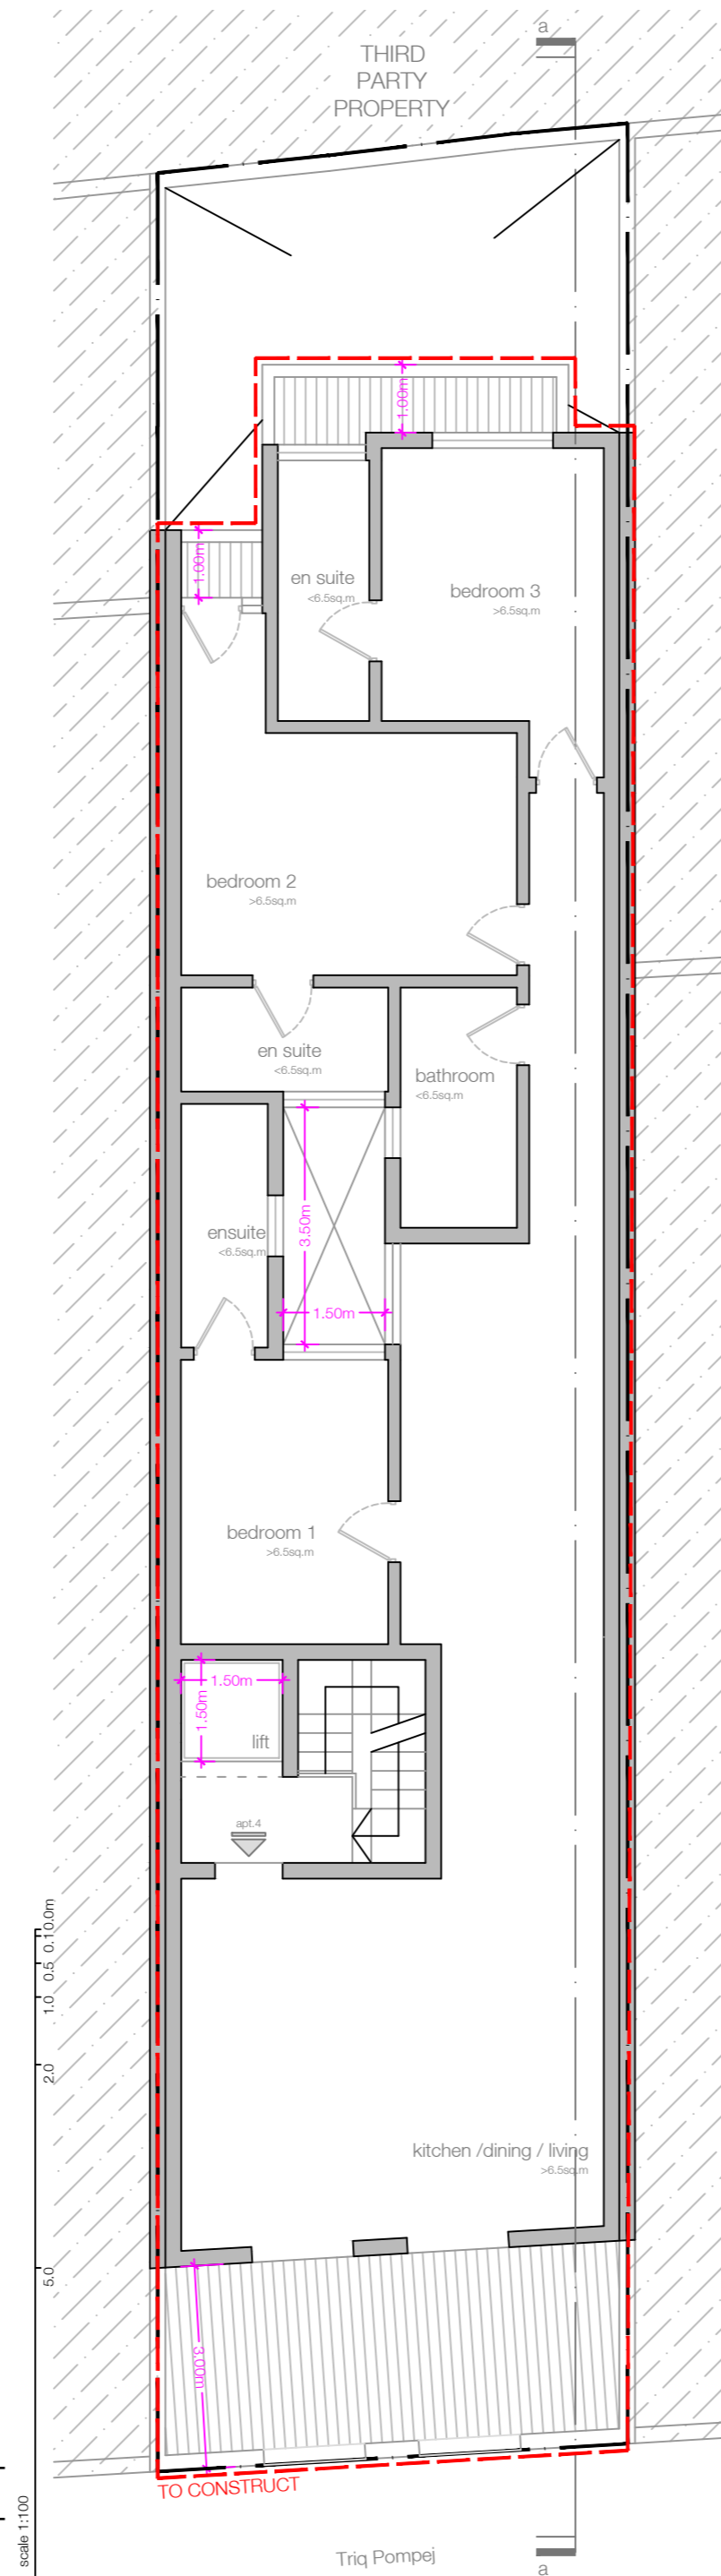

as proposed roof level

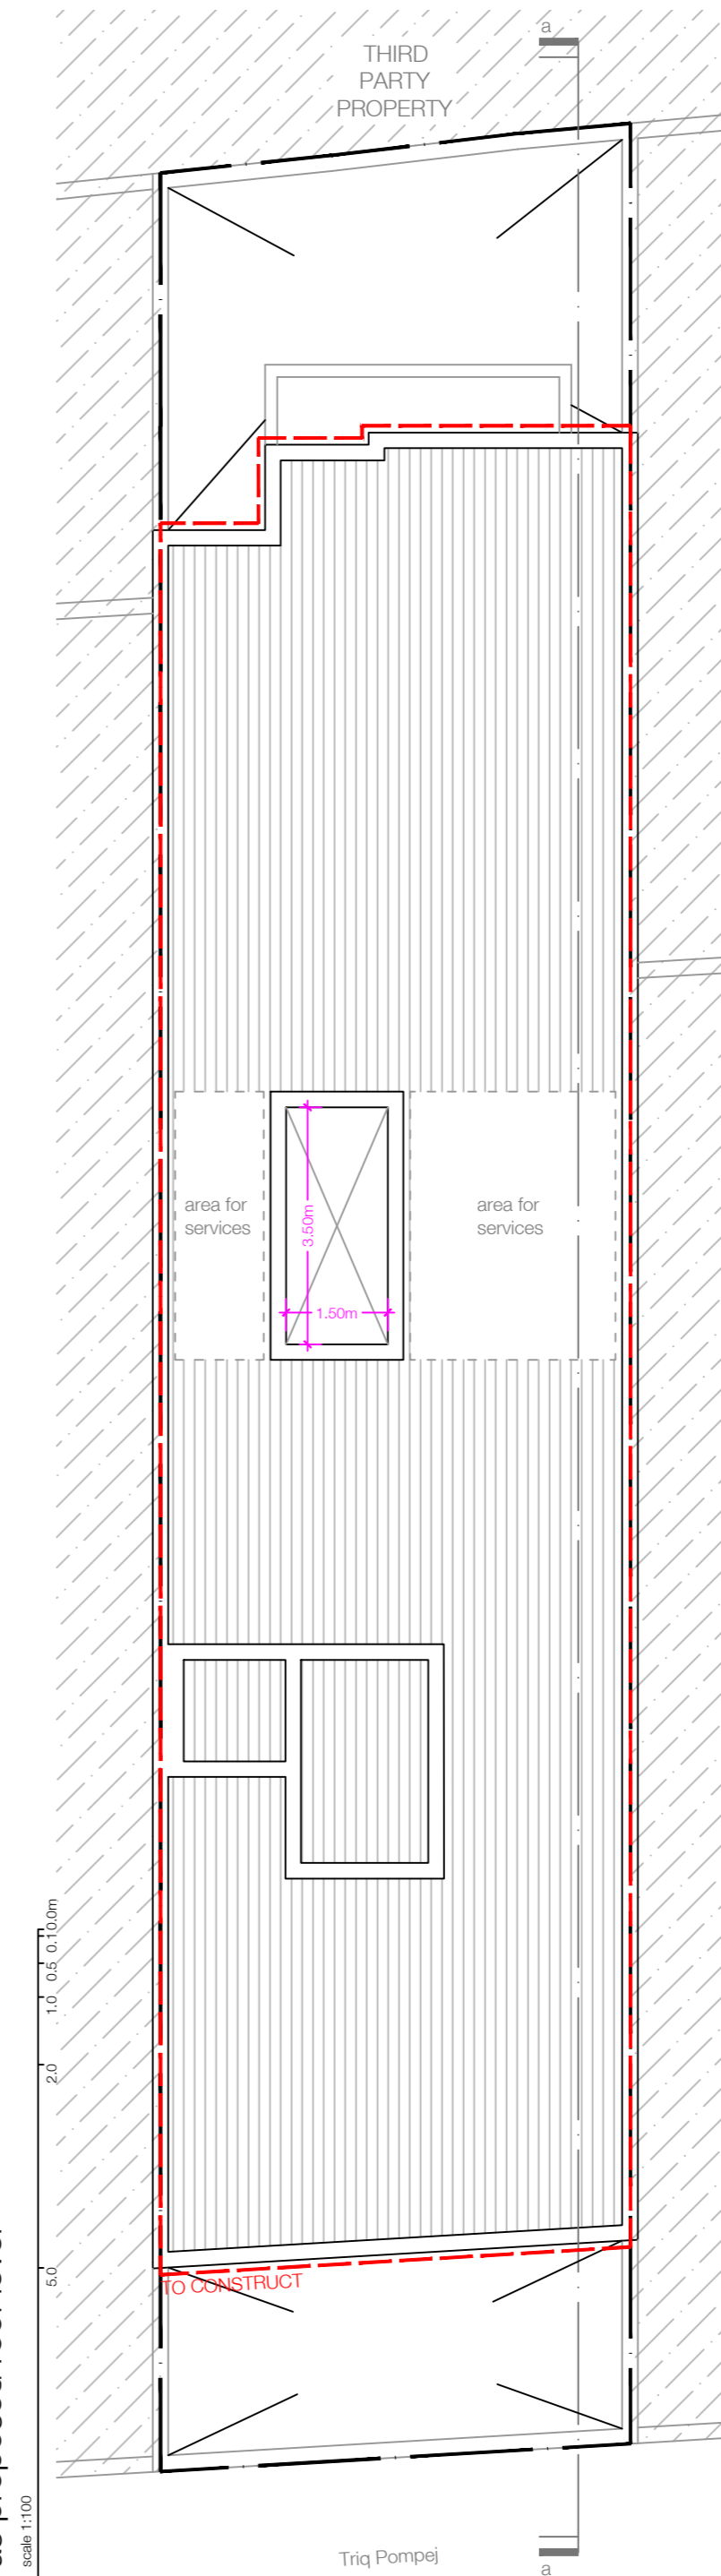

please note:
all dimensions are in mm unless otherwise stated. please do not scale off this drawing

All information and material illustrated on this document are subject to copyright owned by the ACT_N architects & civil engineers. Any reproduction, retransmission, equalization, or other use of all or part of this document is expressly prohibited, unless prior written permission has been granted by ACT_N or the appropriate copyright owner. All other rights reserved.

Copyright © ACT_N architects and civil engineers. All rights reserved.

LEGEND

■	to construct	■	to demolish
■	as approved but not constructed	■	to sanction: as built
	third party properties		
	glass		
	outdoor areas		

drawing purpose

<input type="checkbox"/>	design
<input type="checkbox"/>	construction
<input type="checkbox"/>	for information only

rev. no.: date: description:

ACT_N
architects + civil engineers

90 / ACT_N studio, ganu street, birikikara, BKR1105, malta
t: +356 21318184 www.actn-studio.com
f: @ACTNace p.no.: P/19

perit **CHARLES AZZOPARDI**
A.C.E., B.E.SA (hons)
e : c.azzopardi@actn-studio.com m: +356 99292993
warrant number: 680

perit **DORIANNE ELLIS**
M.Sc. (Struct. Eng) (Surv), A.C.E., B.E.SA (hons)
e : d.ellis@actn-studio.com m: +356 9929125
warrant number: 658

client: **ms. anne ellis**

description: amendments to PA/00367/21, extension of second floor level and construction of a third recessed floor at vacant site in Triq Pompej, Victoria

location: **victoria, gozo**


drawing title: **receded floor level to roof level**

scale: 1:100 @ A2 dwg. no.: 004 revision no.: R00
date: 2021/09/22 PA no.: drawn by: V.C.

reference: **VCT.AE.01**


as proposed section aa

scale 1:100

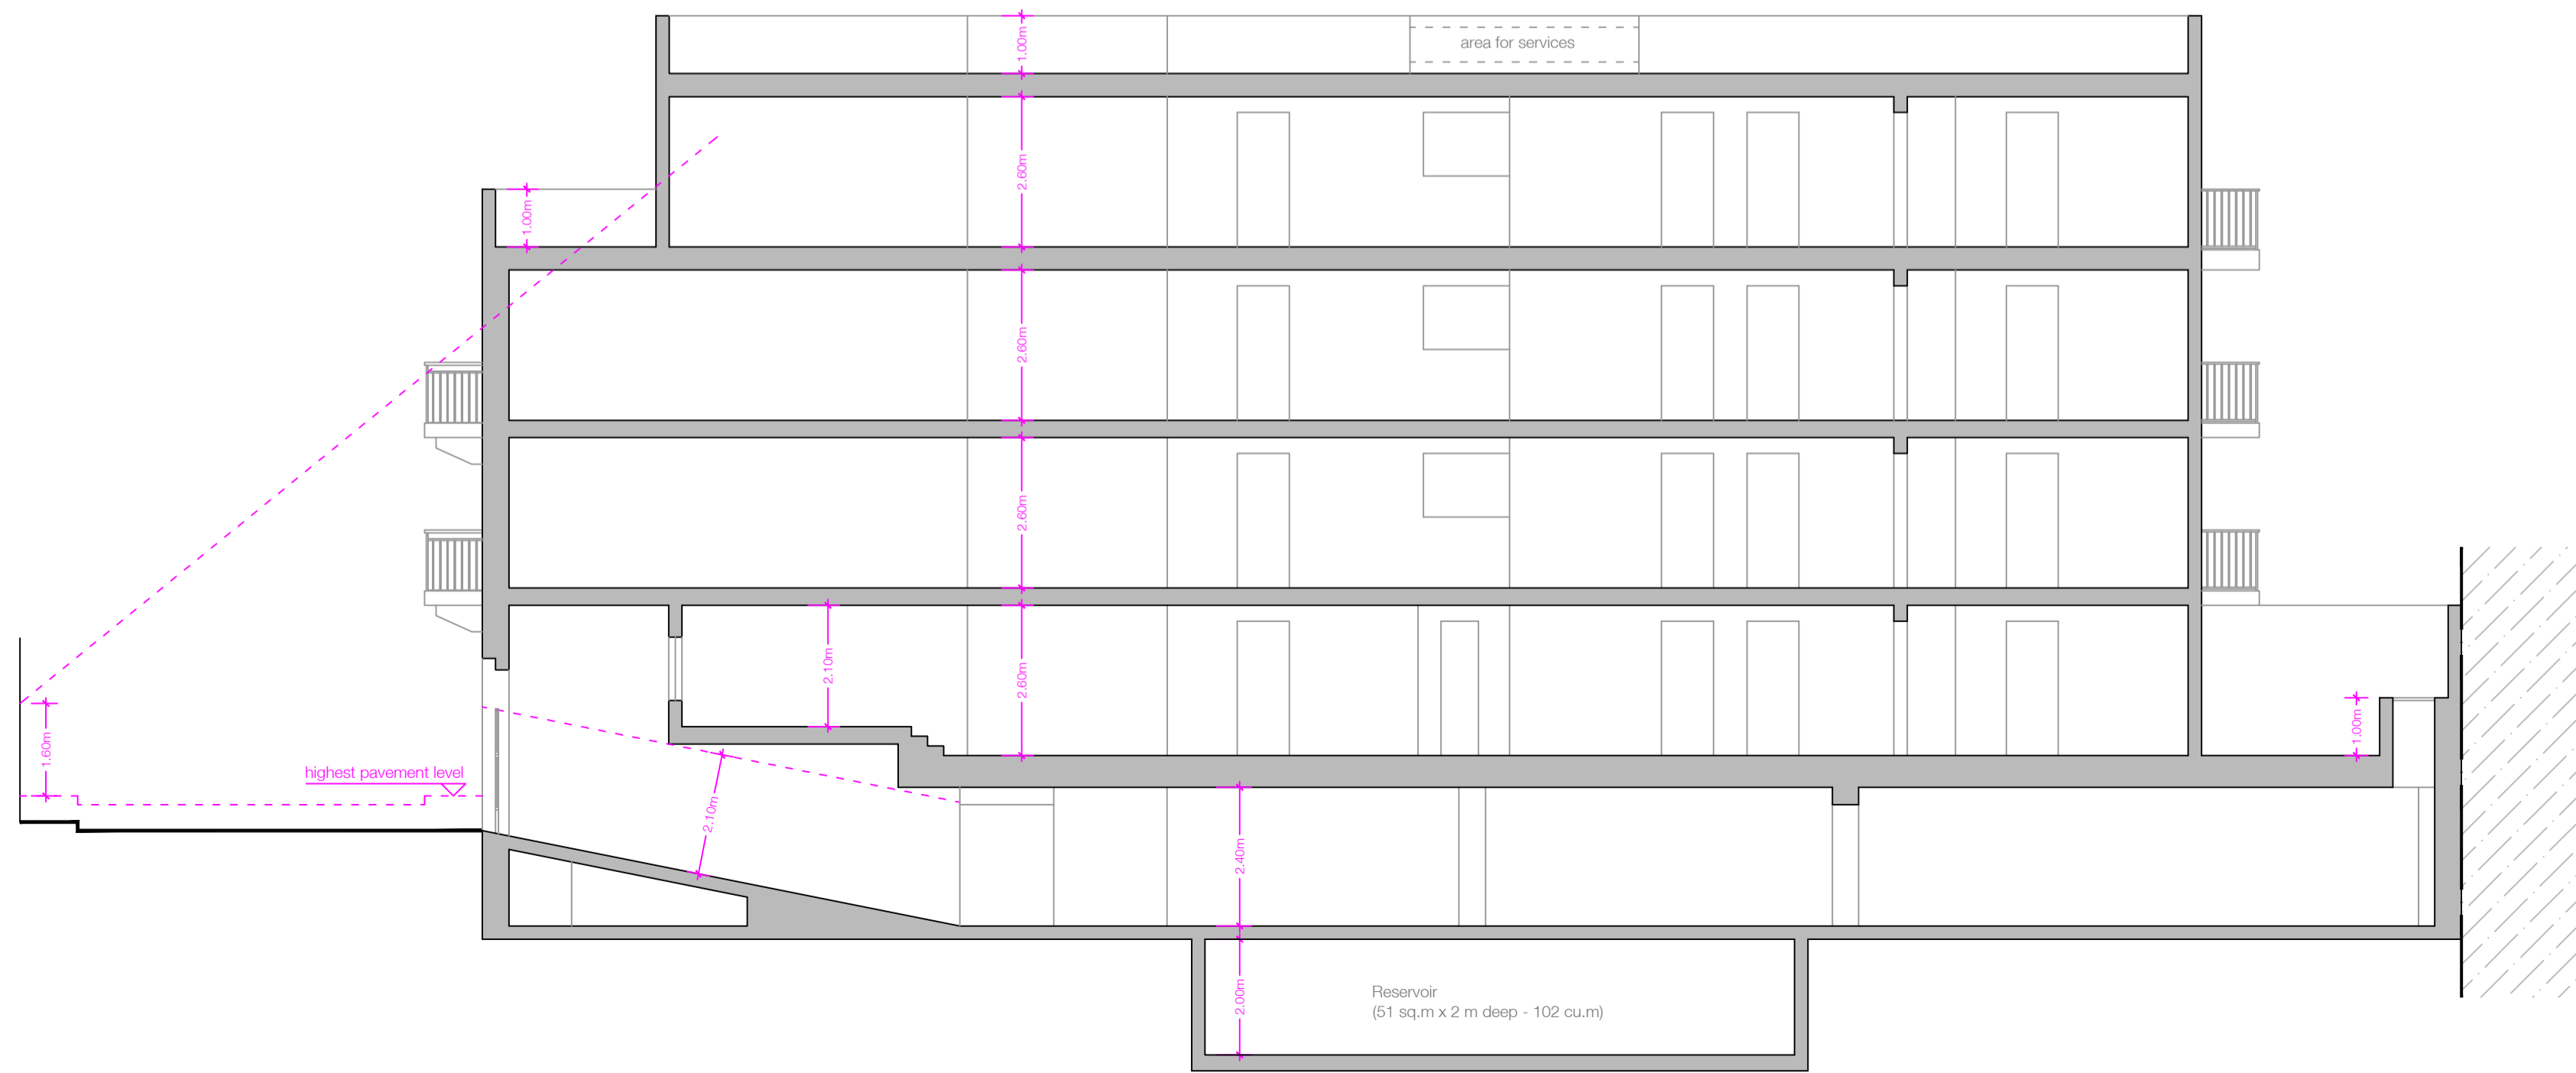


as proposed section aa (w/ changes)

scale 1:100

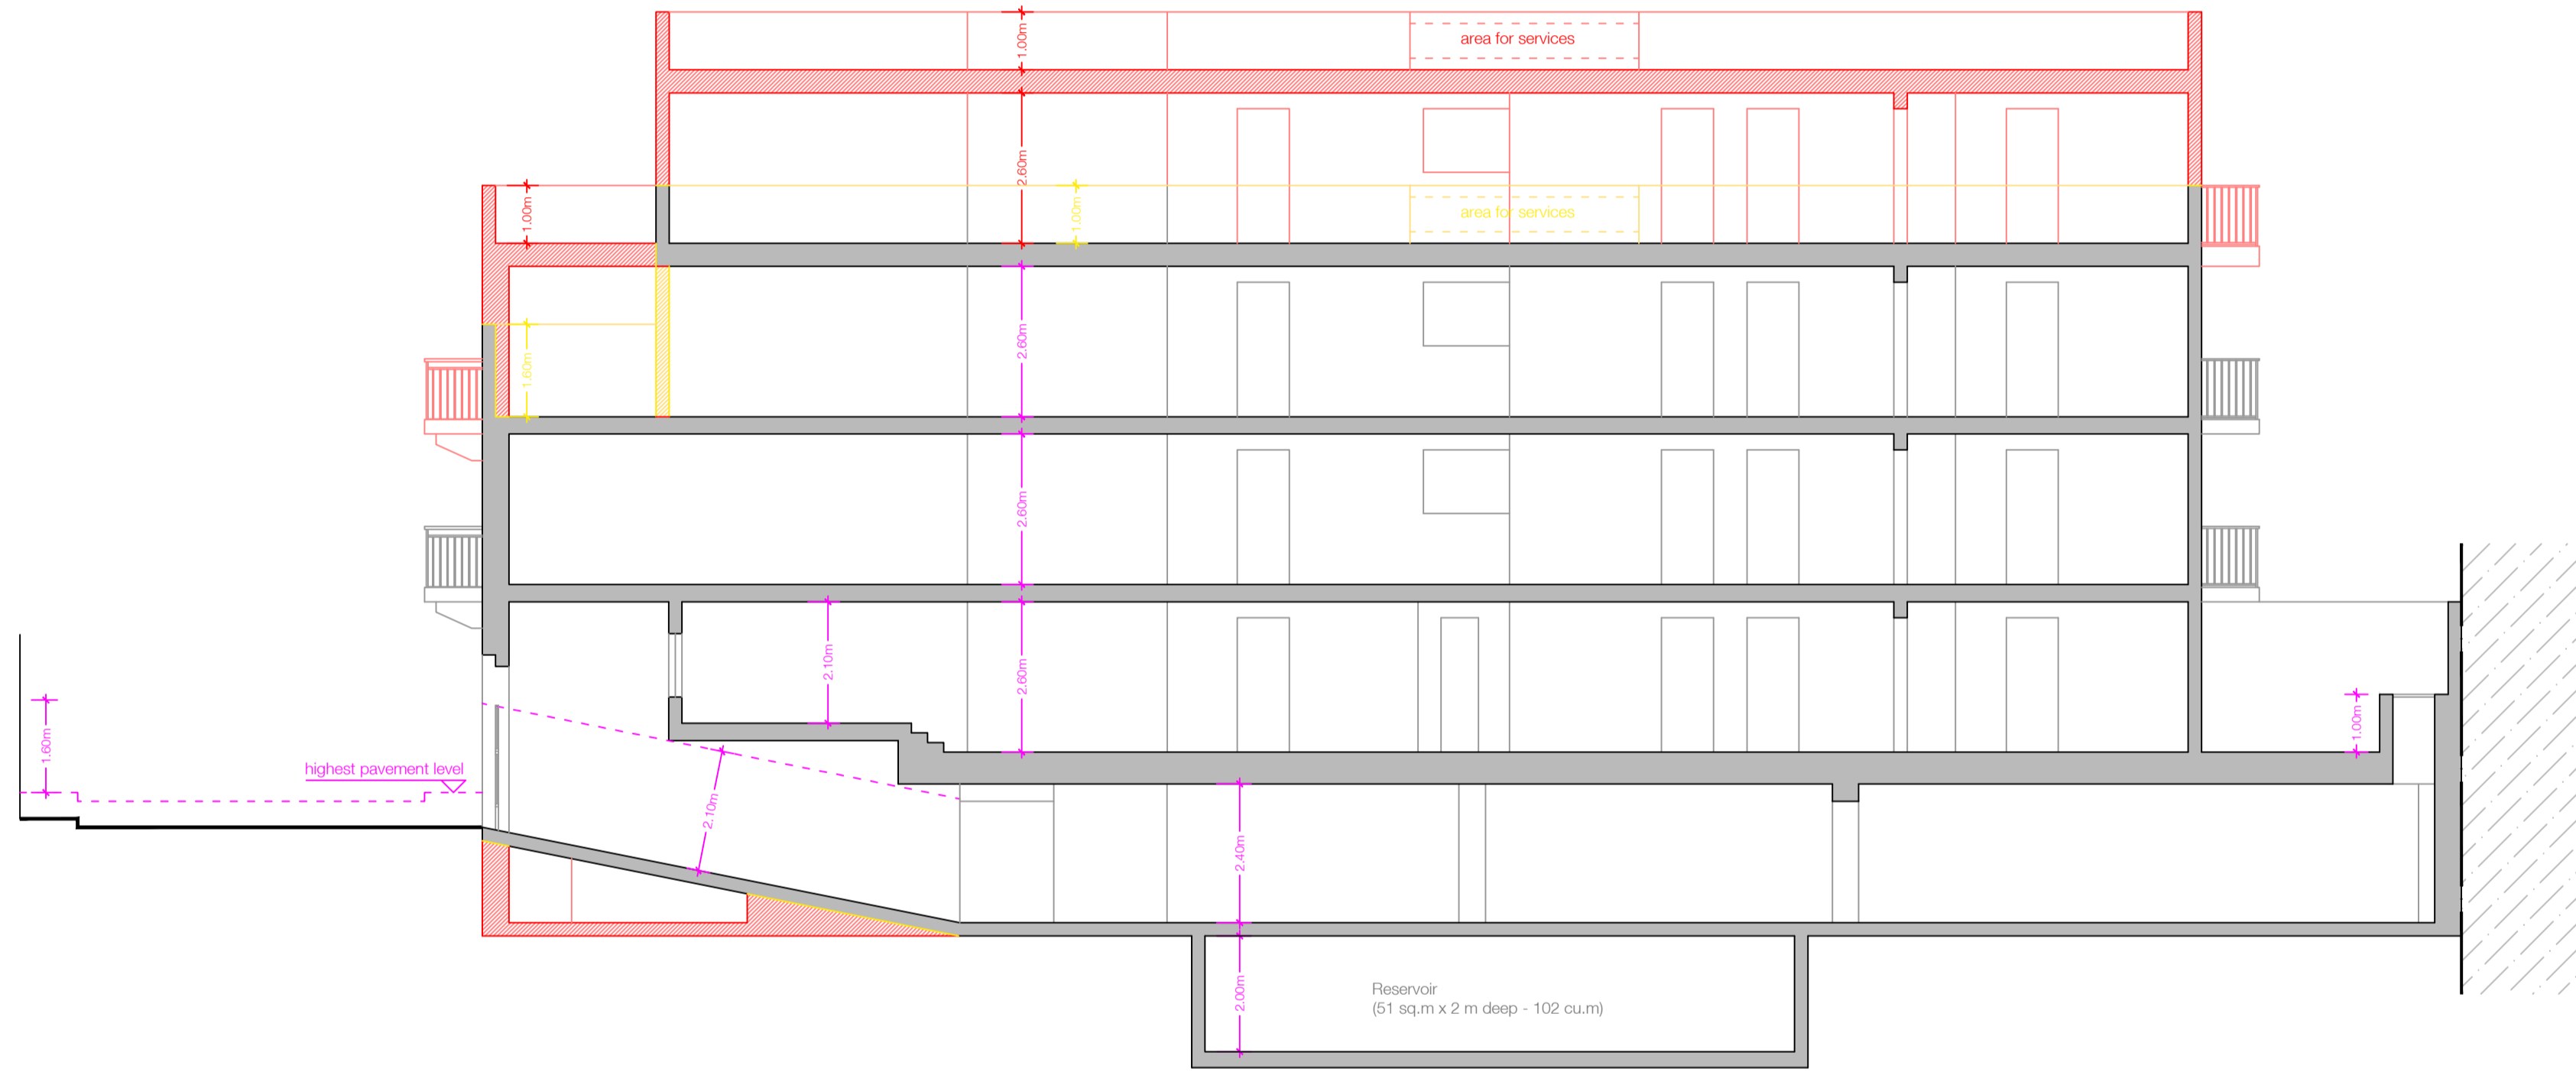

as approved section aa in PA/00367/21

scale 1:100

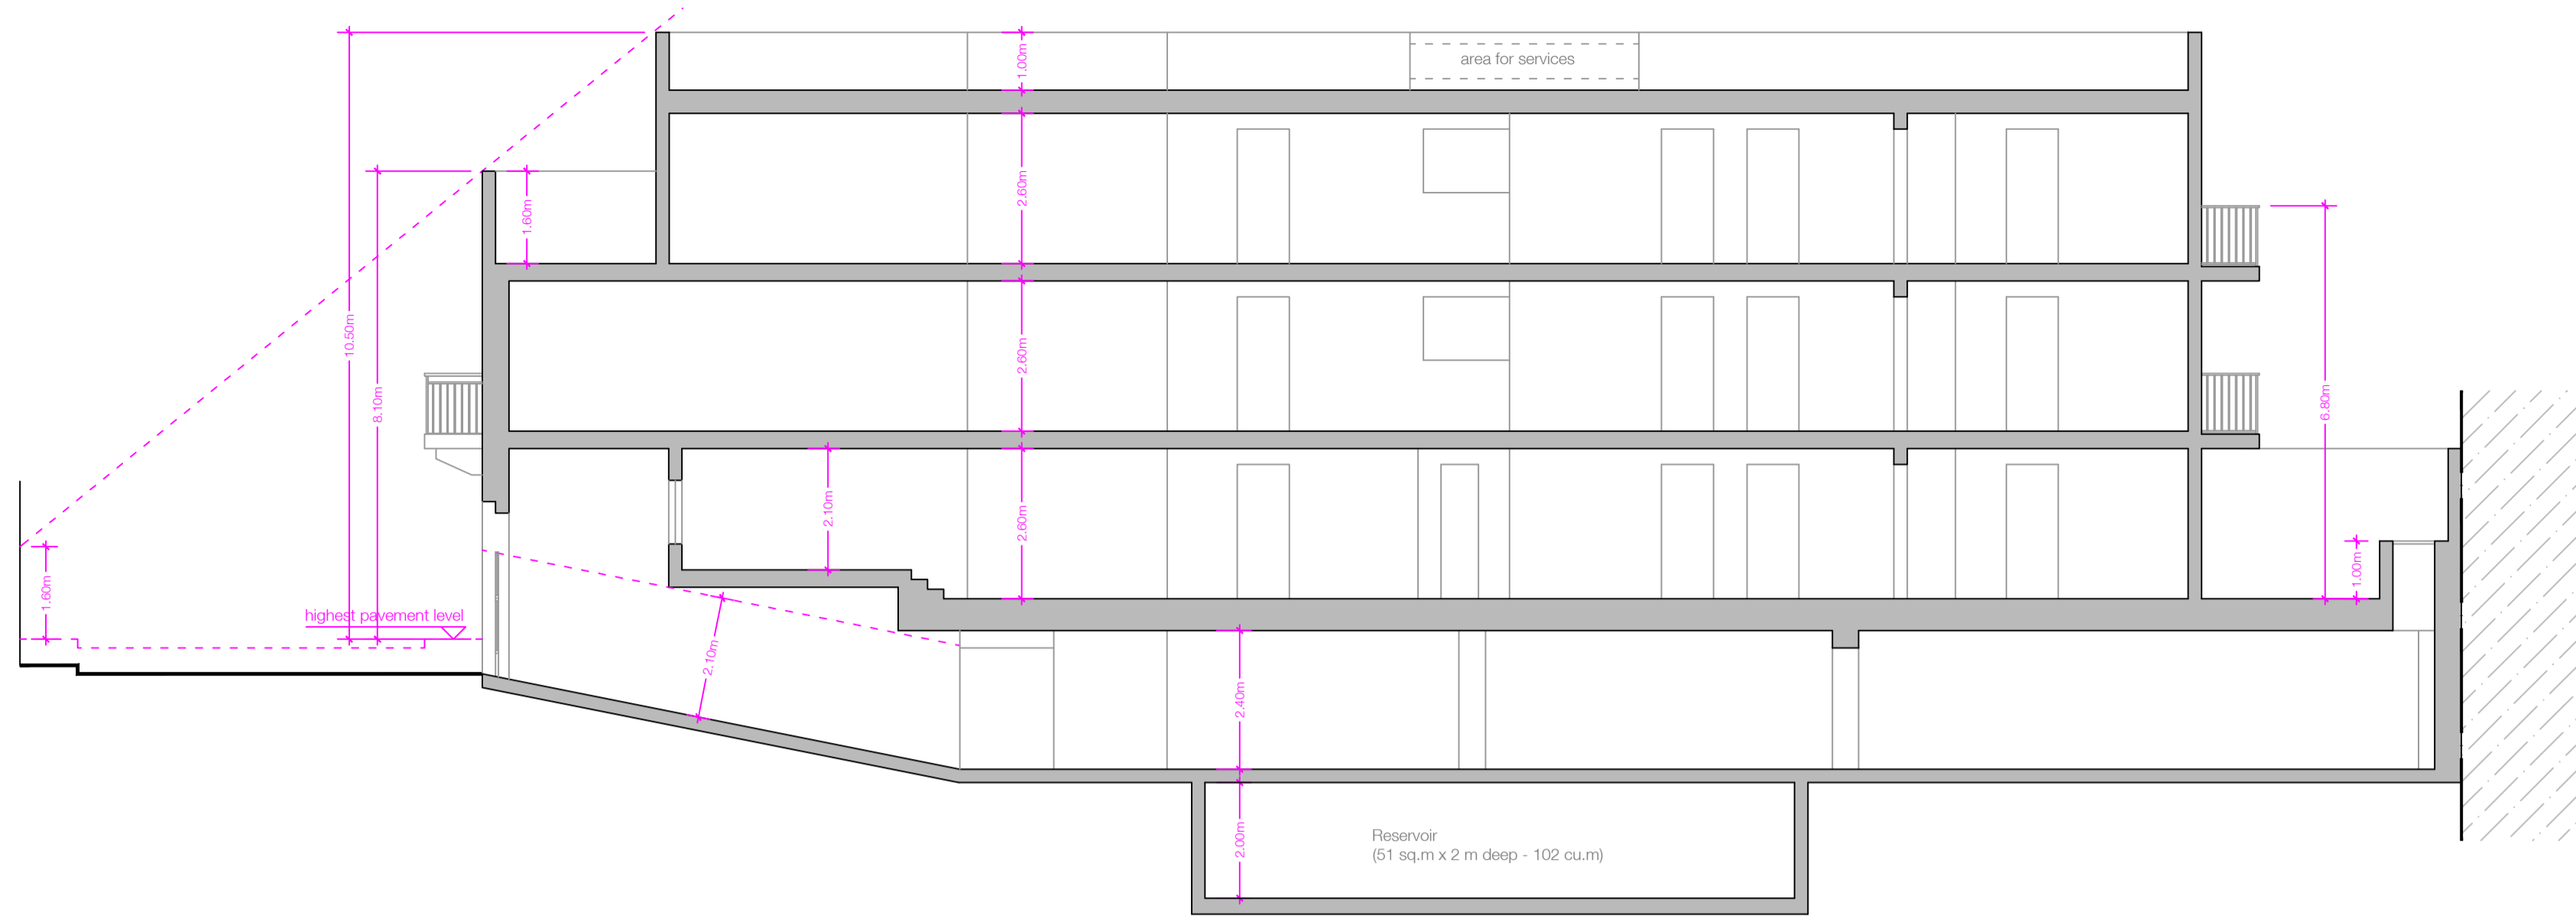

RESERVOIR BASEMENT LEVEL GROUND FLOOR FIRST FLOOR RECESSED FLOOR ROOF

RESERVOIR BASEMENT LEVEL GROUND FLOOR FIRST FLOOR RECESSED FLOOR ROOF

RESERVOIR BASEMENT LEVEL GROUND FLOOR FIRST FLOOR RECESSED FLOOR ROOF

RESERVOIR BASEMENT LEVEL GROUND FLOOR FIRST FLOOR RECESSED FLOOR ROOF

please note:
all dimensions are in mm unless otherwise stated. please do not scale off this drawing

All information and material furnished on this document are subject to copyright owned by the ACT_N architects & civil engineers. Any reproduction, transmission, publication, or other use of all or part of the document is expressly prohibited, unless prior written permission has been granted by ACT_N or the appropriate copyright owner. All other rights reserved.

Copyright © ACT_N architects and civil engineers. All rights reserved.

LEGEND

to construct	to demolish
as approved but not constructed	to sanction as built
third party properties	
glass	
outdoor areas	

drawing purpose	
design	
construction	
for information only	
rev. no.	date
1	2021/09/22
2	
3	
4	
5	
6	
7	
8	
9	
10	

ACT_N
architects + civil engineers

90 / ACT_N studio, ganu street, bikkara, BQR1105, mala
t: +356 21318184 www.actn-studio.com
f: @ACTNace p.no: P119

perit **CHARLES AZZOPARDI**
A.C.E., R.I.A.S. (hons)
e: c.azzopardi@actn-studio.com m: +356 99292993
warrant number: 680

perit **DORIANNE ELLIS**
M.Sc. (hons), Eng. (Burm), A.R.C.E., R.E.A.A. (hons)
e: d.ellis@actn-studio.com m: +356 99292993
warrant number: 656


client: **ms. anne ellis**

description: amendments to PA/00367/21, extension of second floor level and construction of a third recessed floor at vacant site in Triq Pompej, Victoria

location: victoria, gozo


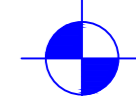


drawing title: as approved / as proposed section aa

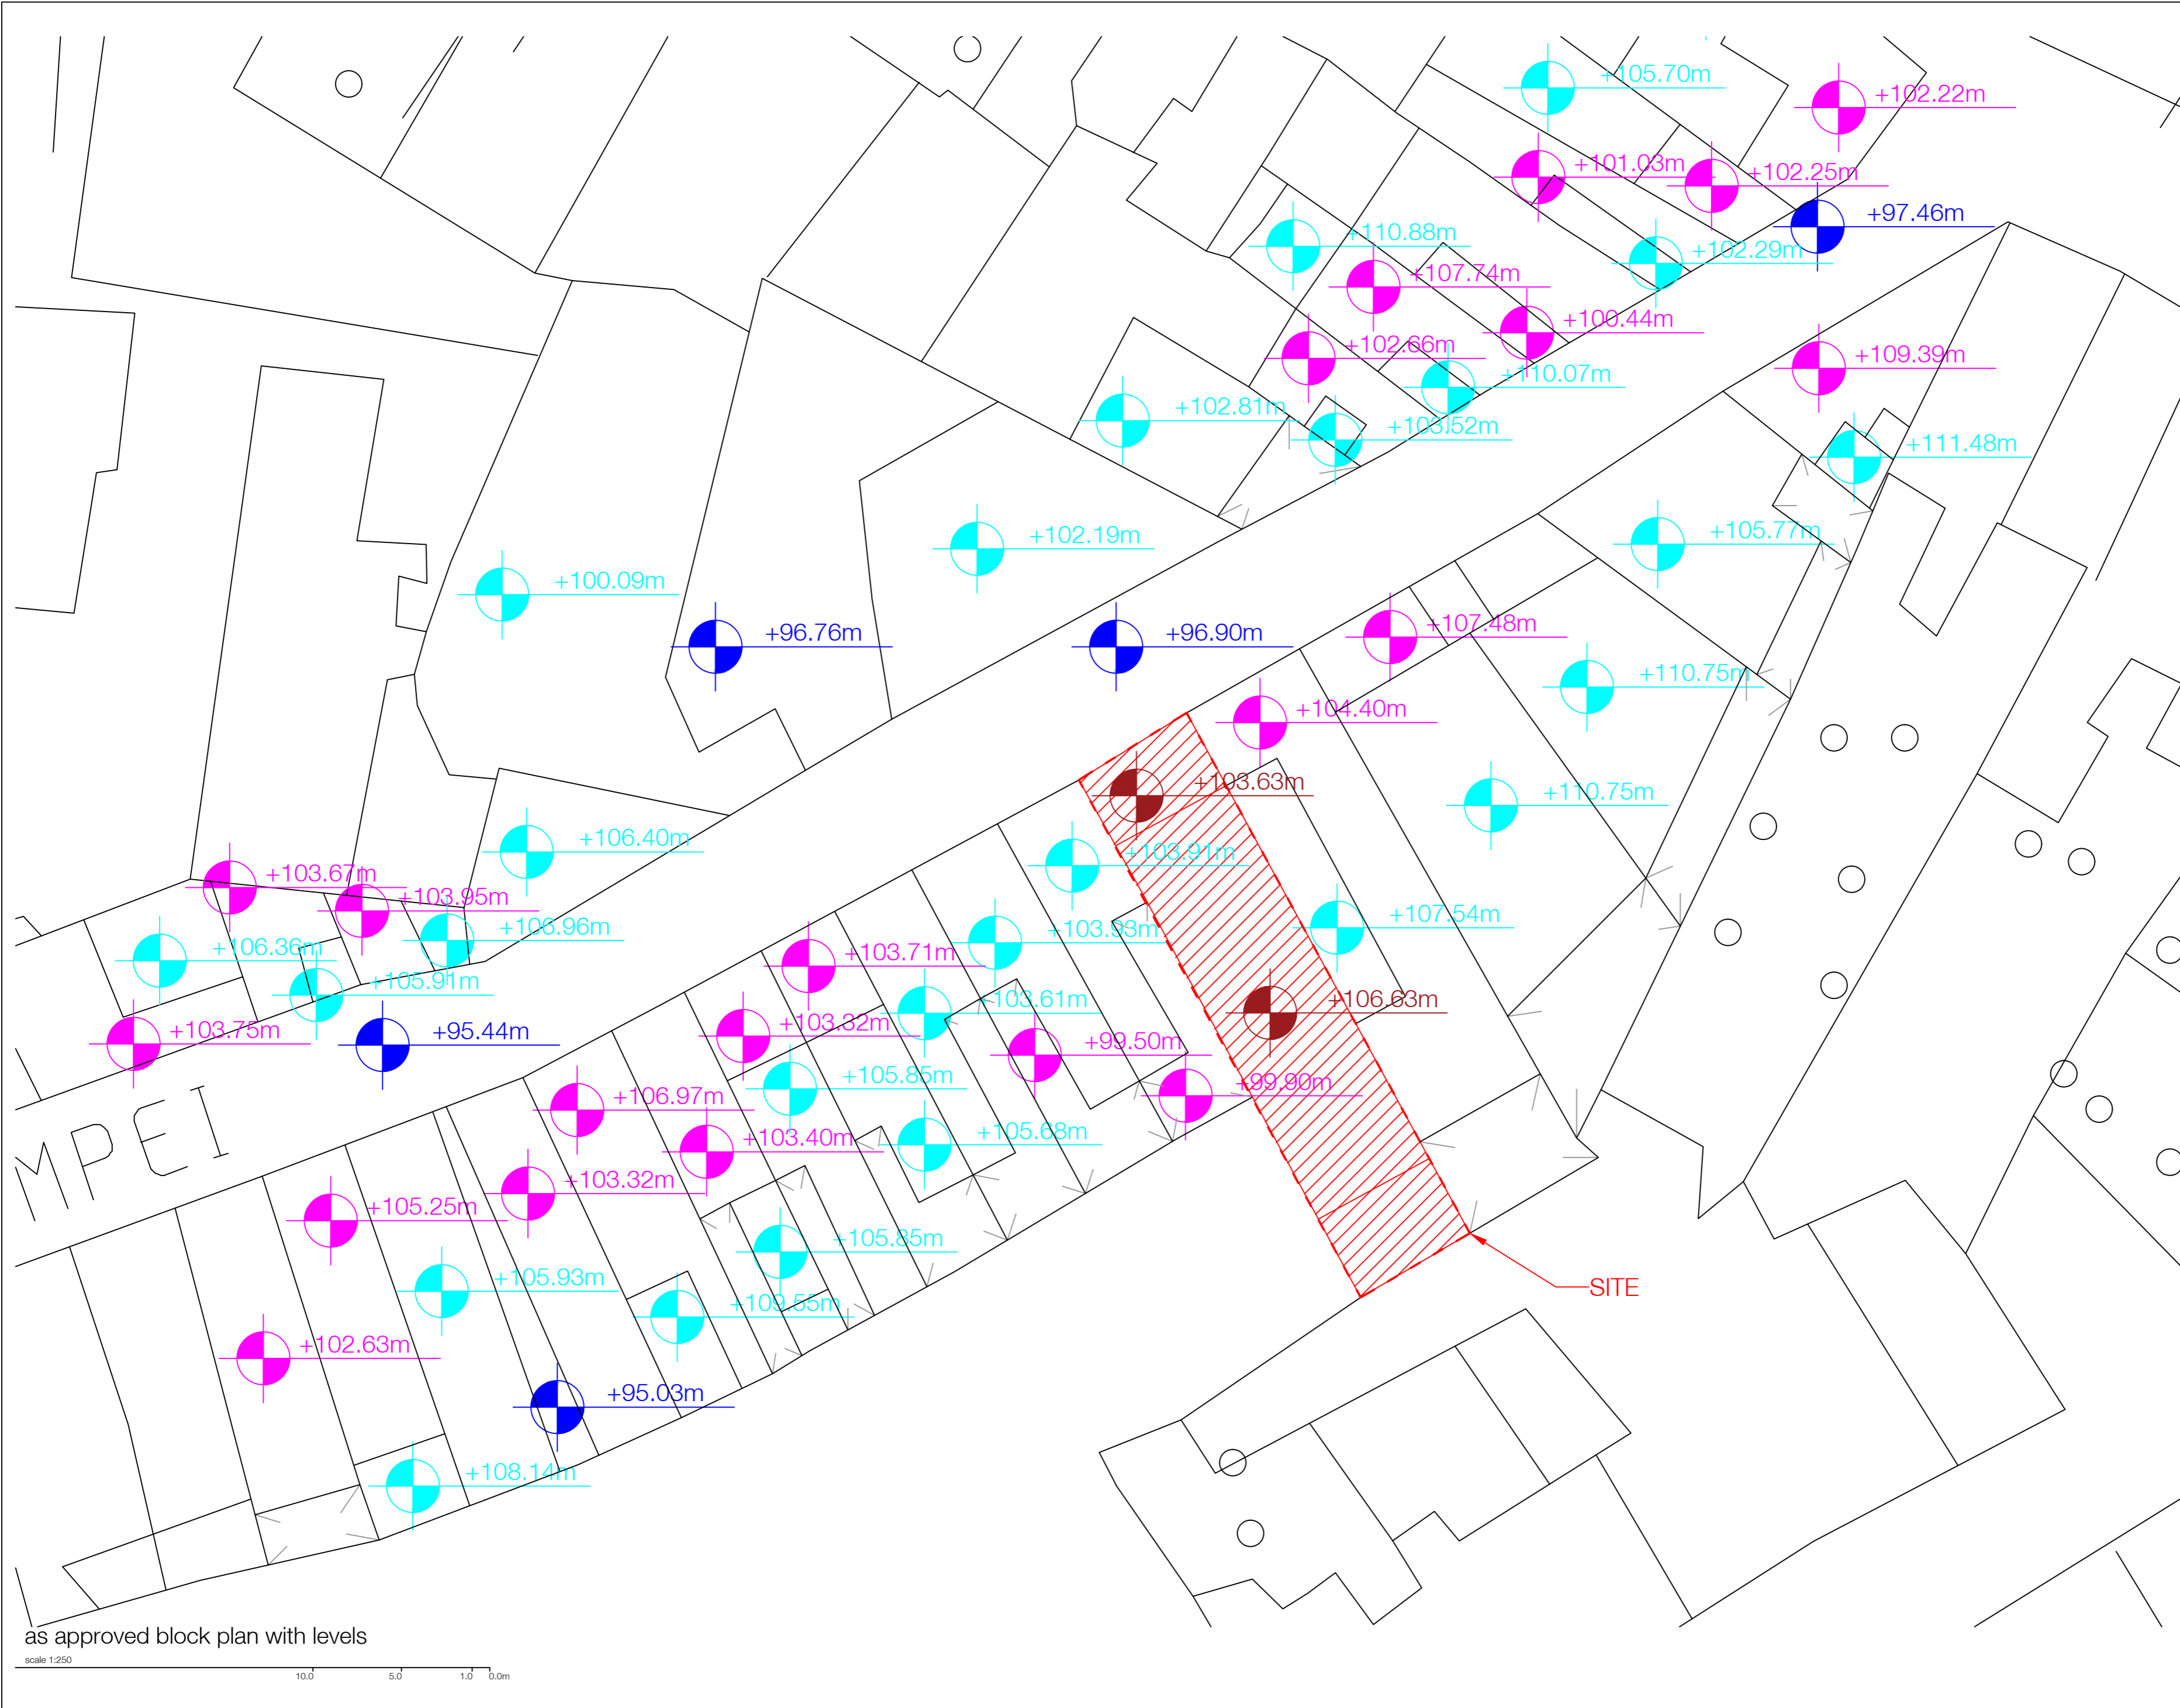scale:	1:100 @ A1	dwg. no.:	006	revision no.:	000
date:	2021/09/22	PA no.:		drawn by:	V.C.
reference:	VCT.AE.01				



as approved block plan with levels
 scale 1:250
 10.0 5.0 1.0 0.0m

please note:
 all dimensions are in mm unless otherwise stated. please do not scale off this drawing
 All information and material illustrated on this document are subject to copyright owned by the ACT_N architects & civil engineers. Any reproduction, retransmission, modification, or other use of all or part of this document is expressly prohibited, unless prior written permission has been granted by ACT_N or the appropriate copyright owner. All other rights reserved.
 Copyright © ACT_N architects and civil engineers. All rights reserved.

-  site
-  road levels
-  ground slab levels
-  roof slab levels

drawing purpose		
design		
construction		
for information only		
rev. no.:	date:	description:
--	---/---/---	--

ACT_N
 architects + civil engineers
 90 / ACT_N studio, ganu street, birikara, BKR1105, malta
 t: +356 21318184 www.actn-studio.com
 f:@ACTNace p.no.: P/19

perit **CHARLES AZZOPARDI**
 A.C.E., B.E.SA (hons)
 e: c.azzopardi@actn-studio.com m: +356 99292993
 warrant number: 680

perit **DORIANNE ELLIS**
 M.Sc. (Struct. Eng.) (Surv.), A.C.E., B.E.SA (hons)
 e: d.ellis@actn-studio.com m: +356 99269125
 warrant number: 658

client:	ms. anne ellis
description:	amendments to PA/00367/21, extension of second floor level and construction of a third recessed floor at vacant site in Triq Pompej, Victoria
location:	victoria, gozo
drawing title:	as approved block plan with levels
scale:	1:250 @ A2
date:	2020/09/22
reference:	VCT.AE.01
dwg. no.:	007
revision no.:	R00
PA no.:	---/---/---
drawn by:	V.C.



please note:
all dimensions are in mm unless otherwise stated. please do not scale off this drawing

All information and material illustrated on this document are subject to copyright owned by the ACT_N architects & civil engineers. Any reproduction, retransmission, modification, or other use of all or part of this document is expressly prohibited, unless prior written permission has been granted by ACT_N or the appropriate copyright owner. All other rights reserved.

Copyright © ACT_N architects and civil engineers. All rights reserved.

-  site
-  1 storey facade
-  2 storeys facade
-  3 storeys facade
-  4 storeys facade
-  3rd storey recessed
-  4th storey recessed

drawing purpose		
design		
construction		
for information only		
rev. no.:	date:	description:
--	---/---/---	--

ACT_N
architects + civil engineers


90 / ACT_N studio, ganu street, birikikara, BKR1105, malta
t: +356 21318184 www.actn-studio.com
f:@ACTNace p.no.: P/19

perit **CHARLES AZZOPARDI**
A.A.C.E., B.E.S.A.(hons)
e: c.azzopardi@actn-studio.com m: +356 99292993
warrant number: 680

perit **DORIANNE ELLIS**
M.Sc. (Struct. Eng.) (Surv.), A.A.C.E., B.E.S.A. (hons)
e: d.ellis@actn-studio.com m: +356 99269125
warrant number: 658

client:	ms. anne ellis
description:	amendments to PA/00367/21, extension of second floor level and construction of a third recessed floor at vacant site in Triq Pompej, Victoria
location:	victoria, gozo
drawing title:	schematic block plan
scale:	1:250 @ A2
dwg. no.:	009
revision no.:	R00
date:	2021/09/22
PA no.:	---/---/---
drawn by:	V.C.
reference:	VCT.AE.01


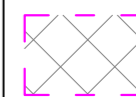


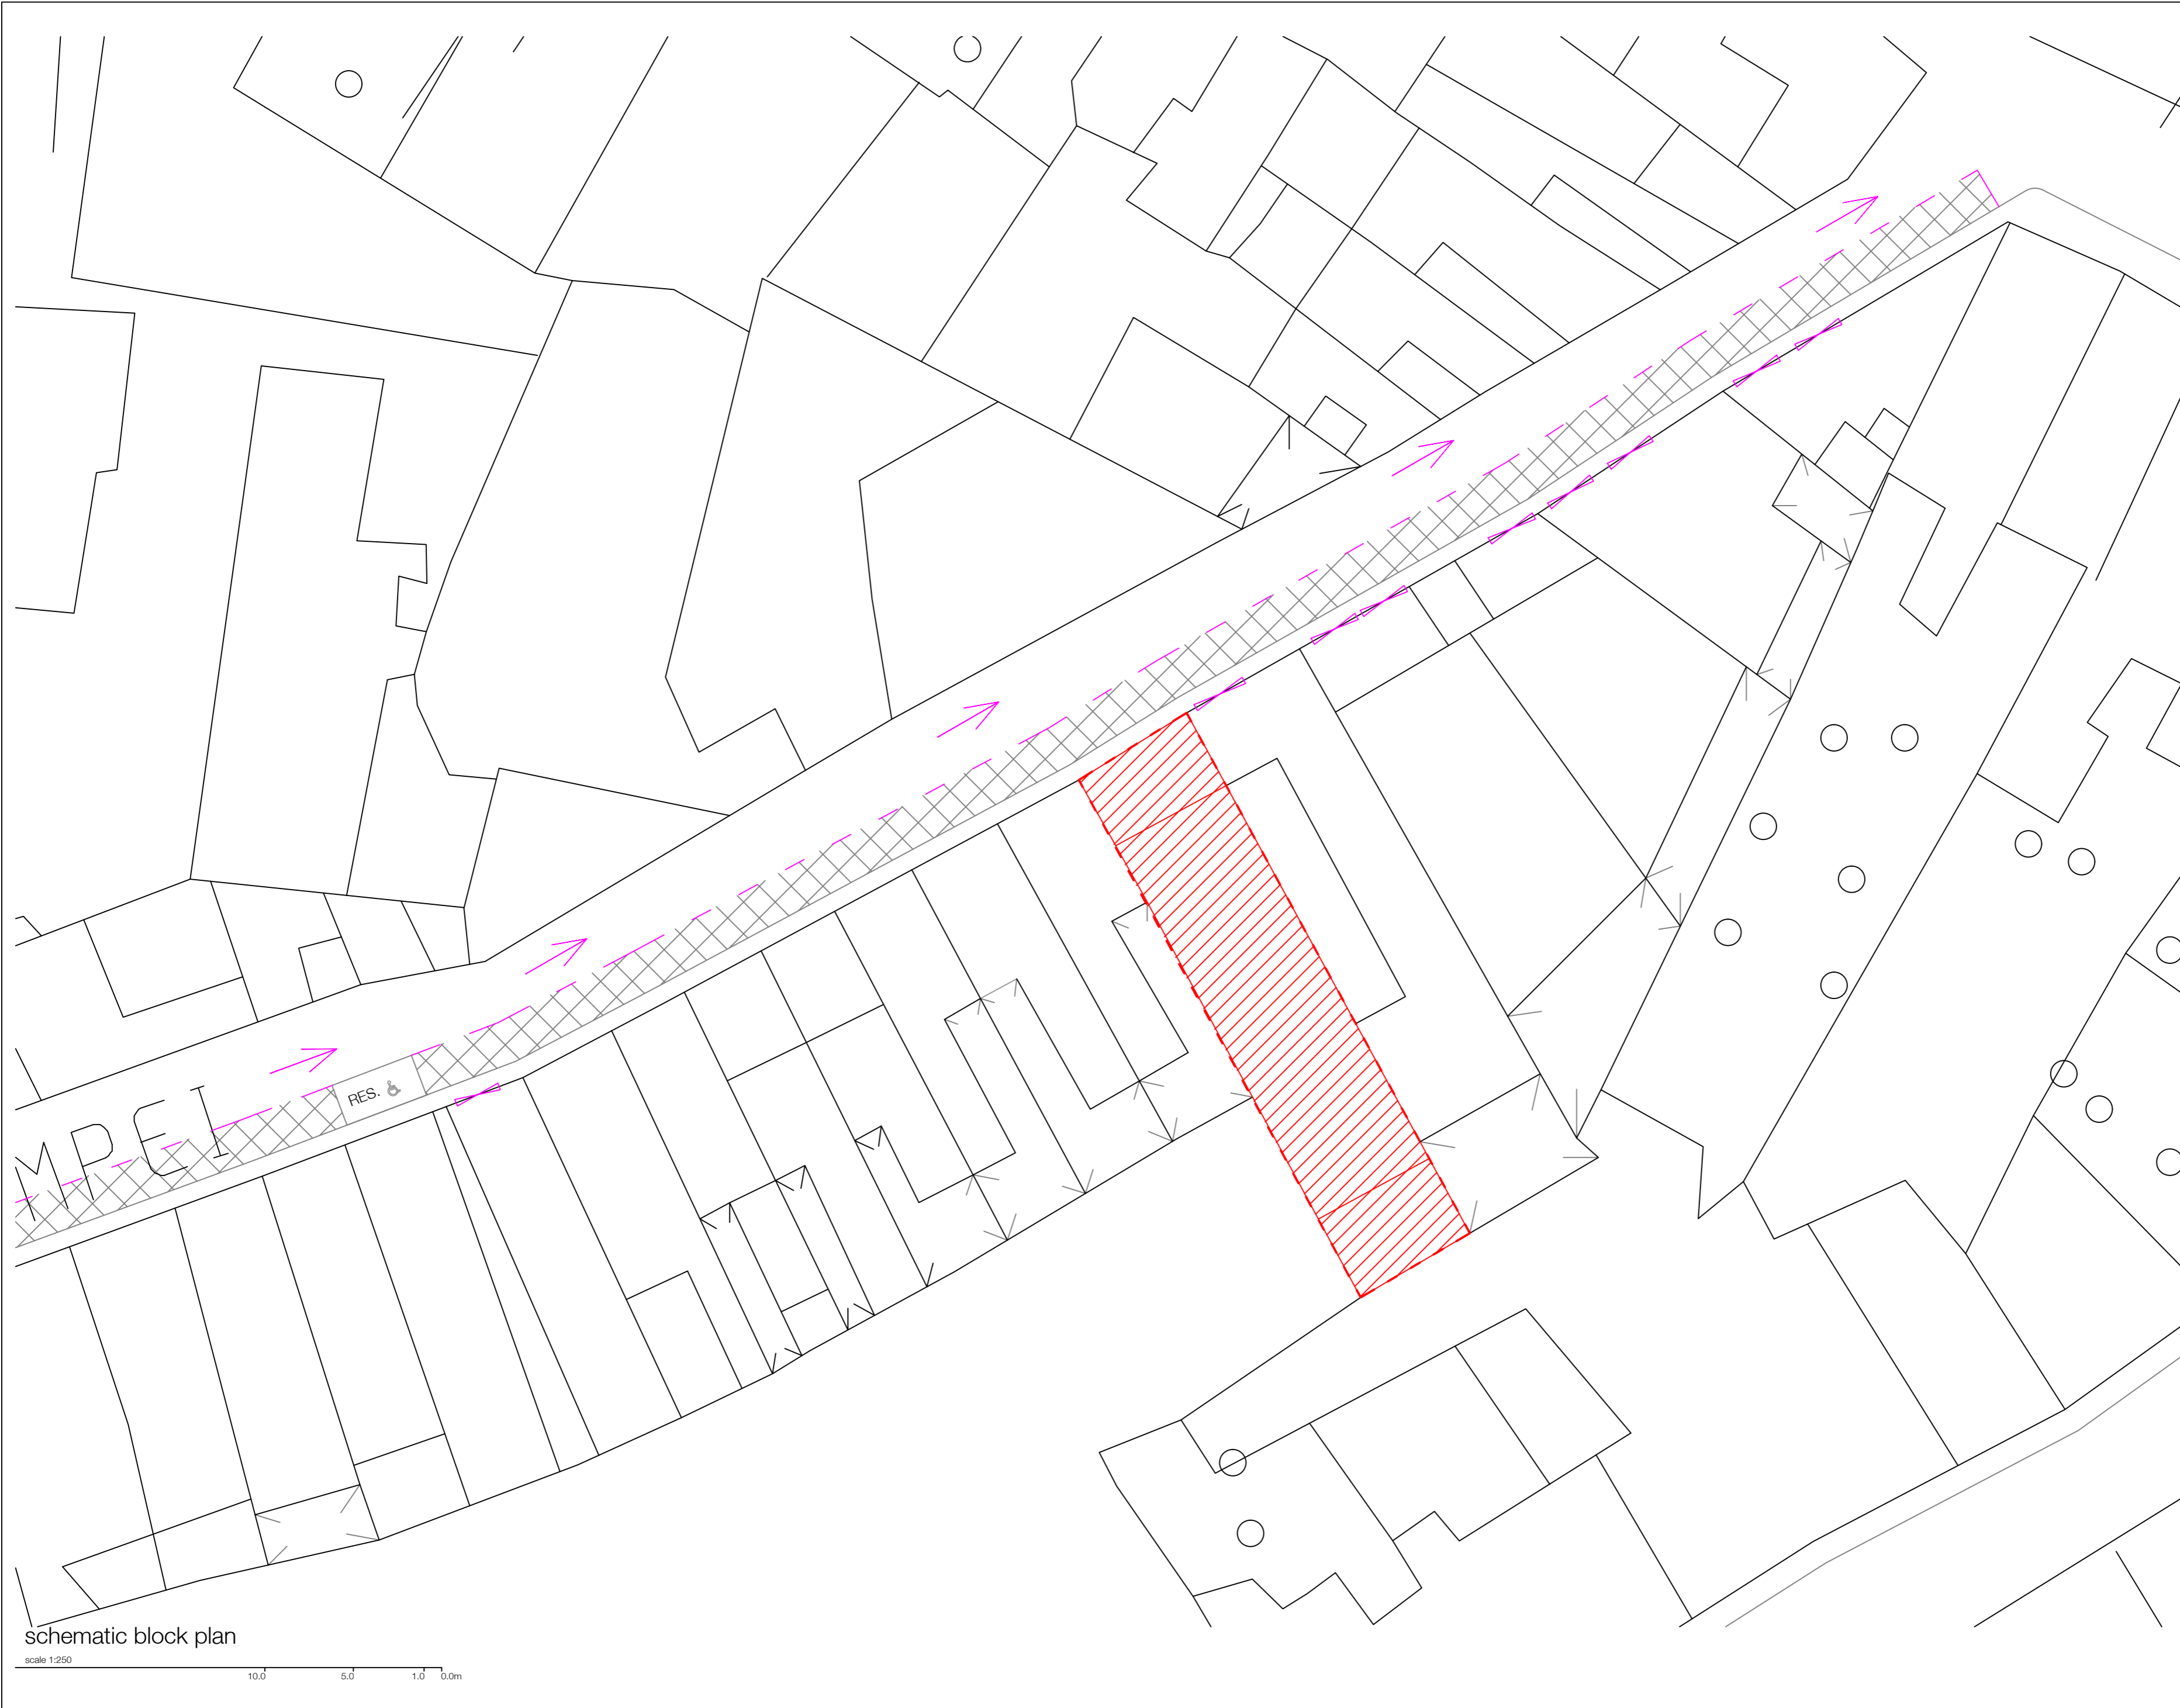
schematic block plan
scale 1:250
10.0 5.0 1.0 0.0m



please note:
 all dimensions are in mm unless otherwise stated. please do not scale off this drawing

All information and material illustrated on this document are subject to copyright owned by the ACT_N architects & civil engineers. Any reproduction, retransmission, modification, or other use of all or part of this document is expressly prohibited, unless prior written permission has been granted by ACT_N or the appropriate copyright owner. All other rights reserved.

Copyright © ACT_N architects and civil engineers. All rights reserved.

-  site
-  no street markings present, yet cars seem to park on marked side
-  one way street
-  garage door
- RES.**  reserved parking space for disable person

drawing purpose		
design		
construction		
for information only		
rev. no.:	date:	description:
--	---/---/---	--

ACT_N
 architects + civil engineers

90 / ACT_N studio, ganu street, birikikara, BKR1105, malta
 t: +356 21318184 www.actn-studio.com
 f:@ACTNace p.no.: P/19

perit **CHARLES AZZOPARDI**
 A.C.E., B.E.SA (hons)
 e : c.azzopardi@actn-studio.com m: +356 99292993
 warrant number: 680

perit **DORIANNE ELLIS**
 M.Sc. (Struct. Eng.) (Surv), A.C.E., B.E.SA (hons)
 e : d.ellis@actn-studio.com m: +356 99269125
 warrant number: 658

client:	ms. anne ellis
description:	amendments to PA/00367/21, extension of second floor level and construction of a third recessed floor at vacant site in Triq Pompej, Victoria
location:	victoria, gozo
drawing title:	schematic block plan
scale:	1:500 @ A2
dwg. no.:	010
revision no.:	R00
date:	2021/09/22
PA no.:	--/---/---
drawn by:	V.C.
reference:	VCT.AE.01

schematic block plan
 scale 1:250
 10.0 5.0 1.0 0.0m