


10
5
0
SCALE BAR 1 : 100

5
4
3
2
1
0
SCALE BAR 1 : 50


SCALE BAR 1 : 100 0 5 10

FOR PLANNING PURPOSES DRAFT
FOR CONSTRUCTION PURPOSES FOR INFORMATION ONLY


- All dimensions are in mm and levels in metres unless otherwise noted.
- Drawing should not be scaled. Use indicated dimensions only.
- This drawing is not to be used as a construction drawing unless otherwise stated.
- Red - To Construct; Yellow - To Demolish
- Green - Approved But Not Constructed;
- Blue - To Be Sanctioned
- Any discrepancies in the drawing shall be brought to the attention of the architect-in-charge within 7 days of receipt.

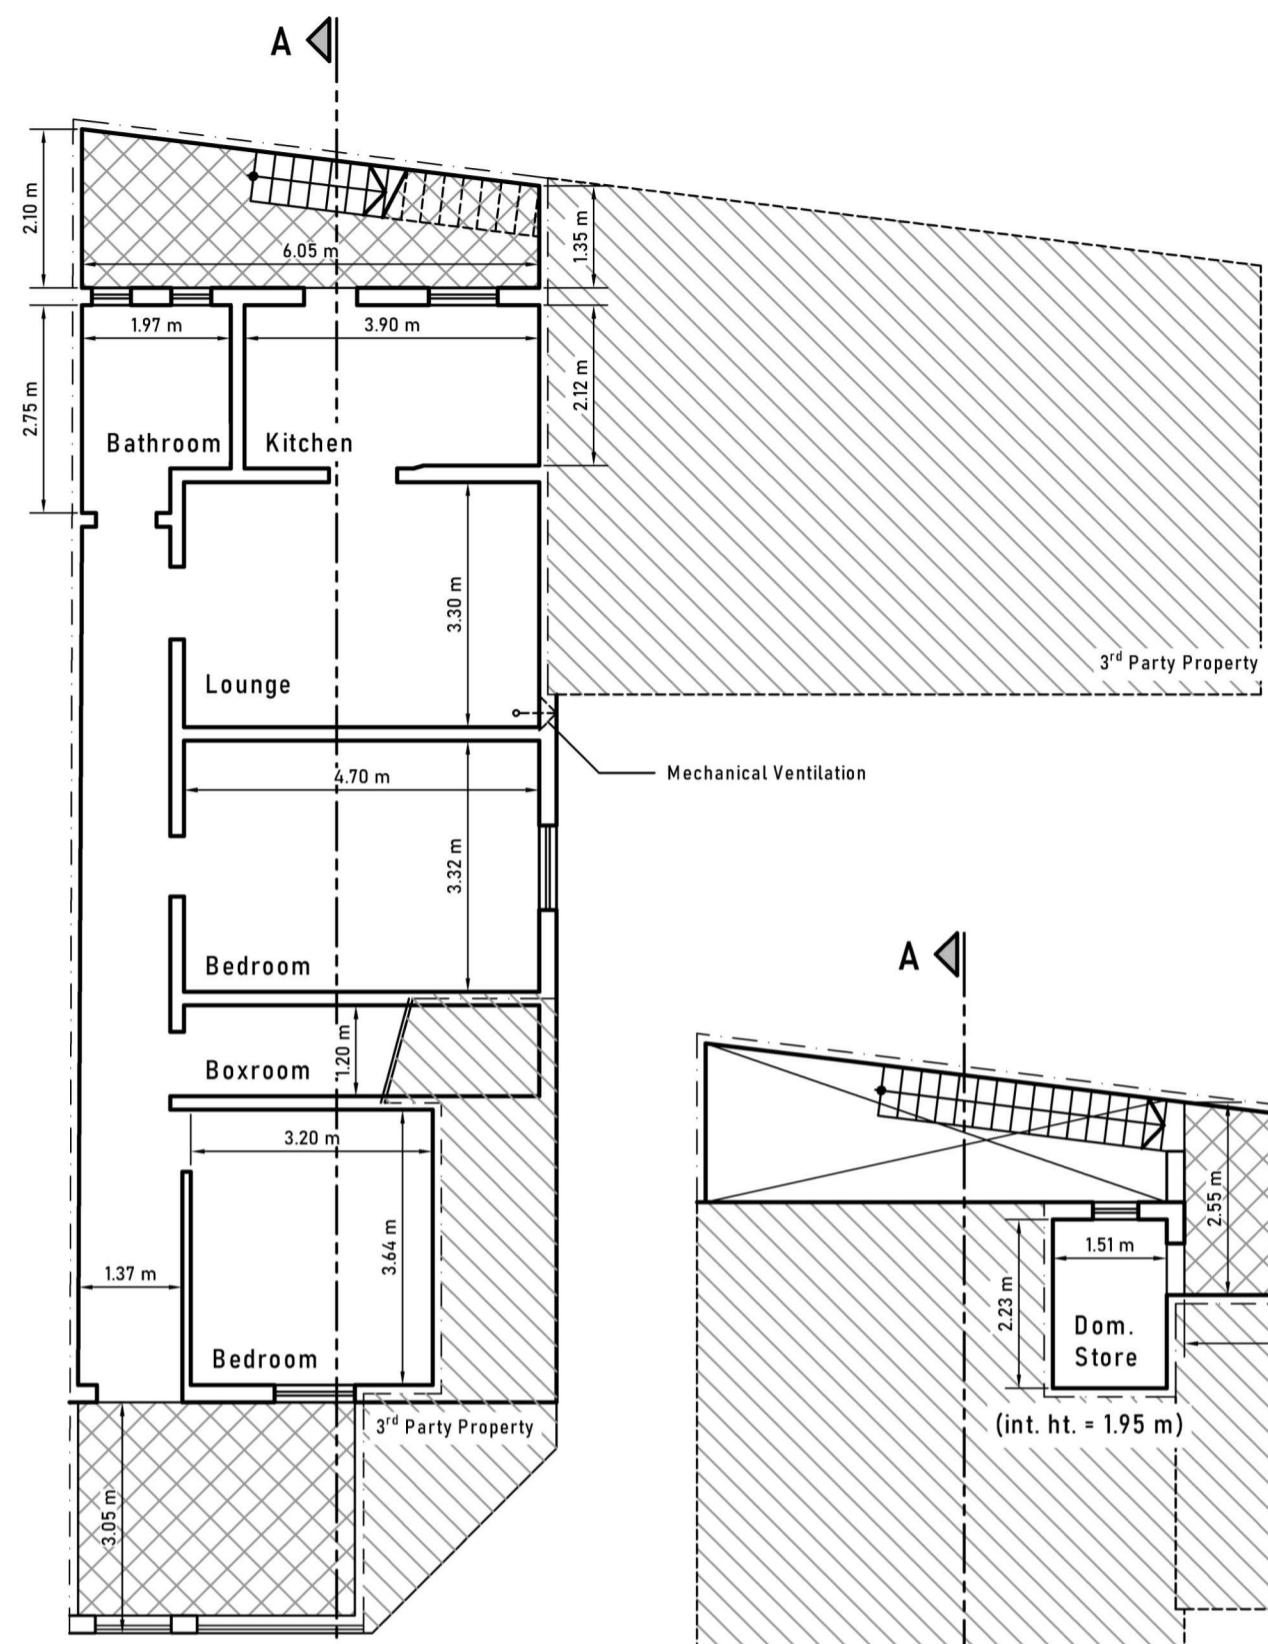


Existing Ground Floor Plan
Scale 1:100
GFA = 85m²

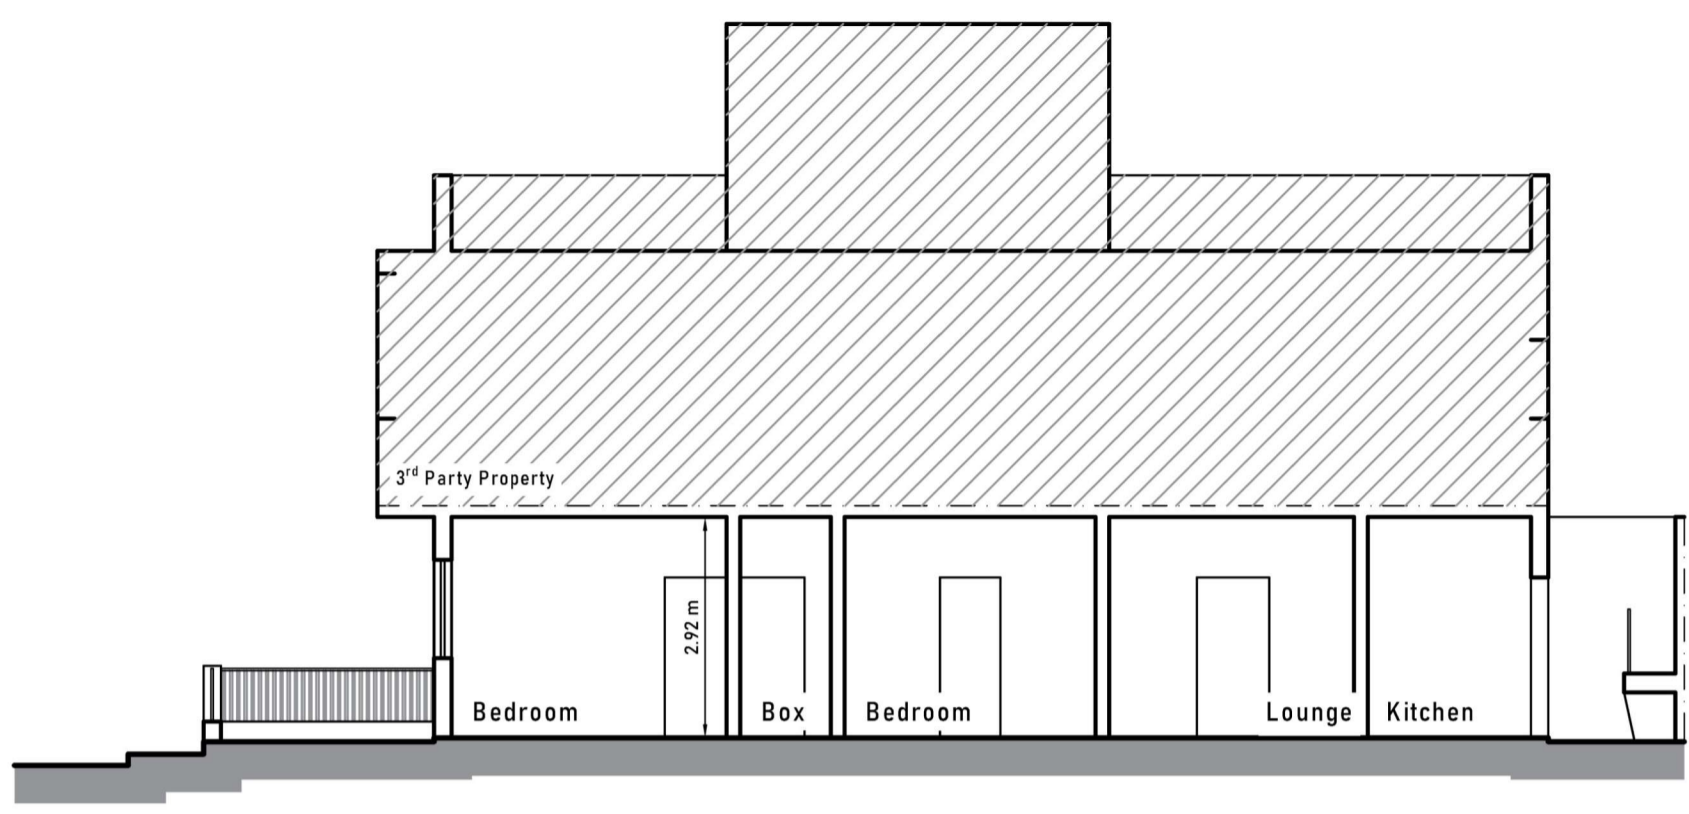


Existing Section AA
Scale 1:100

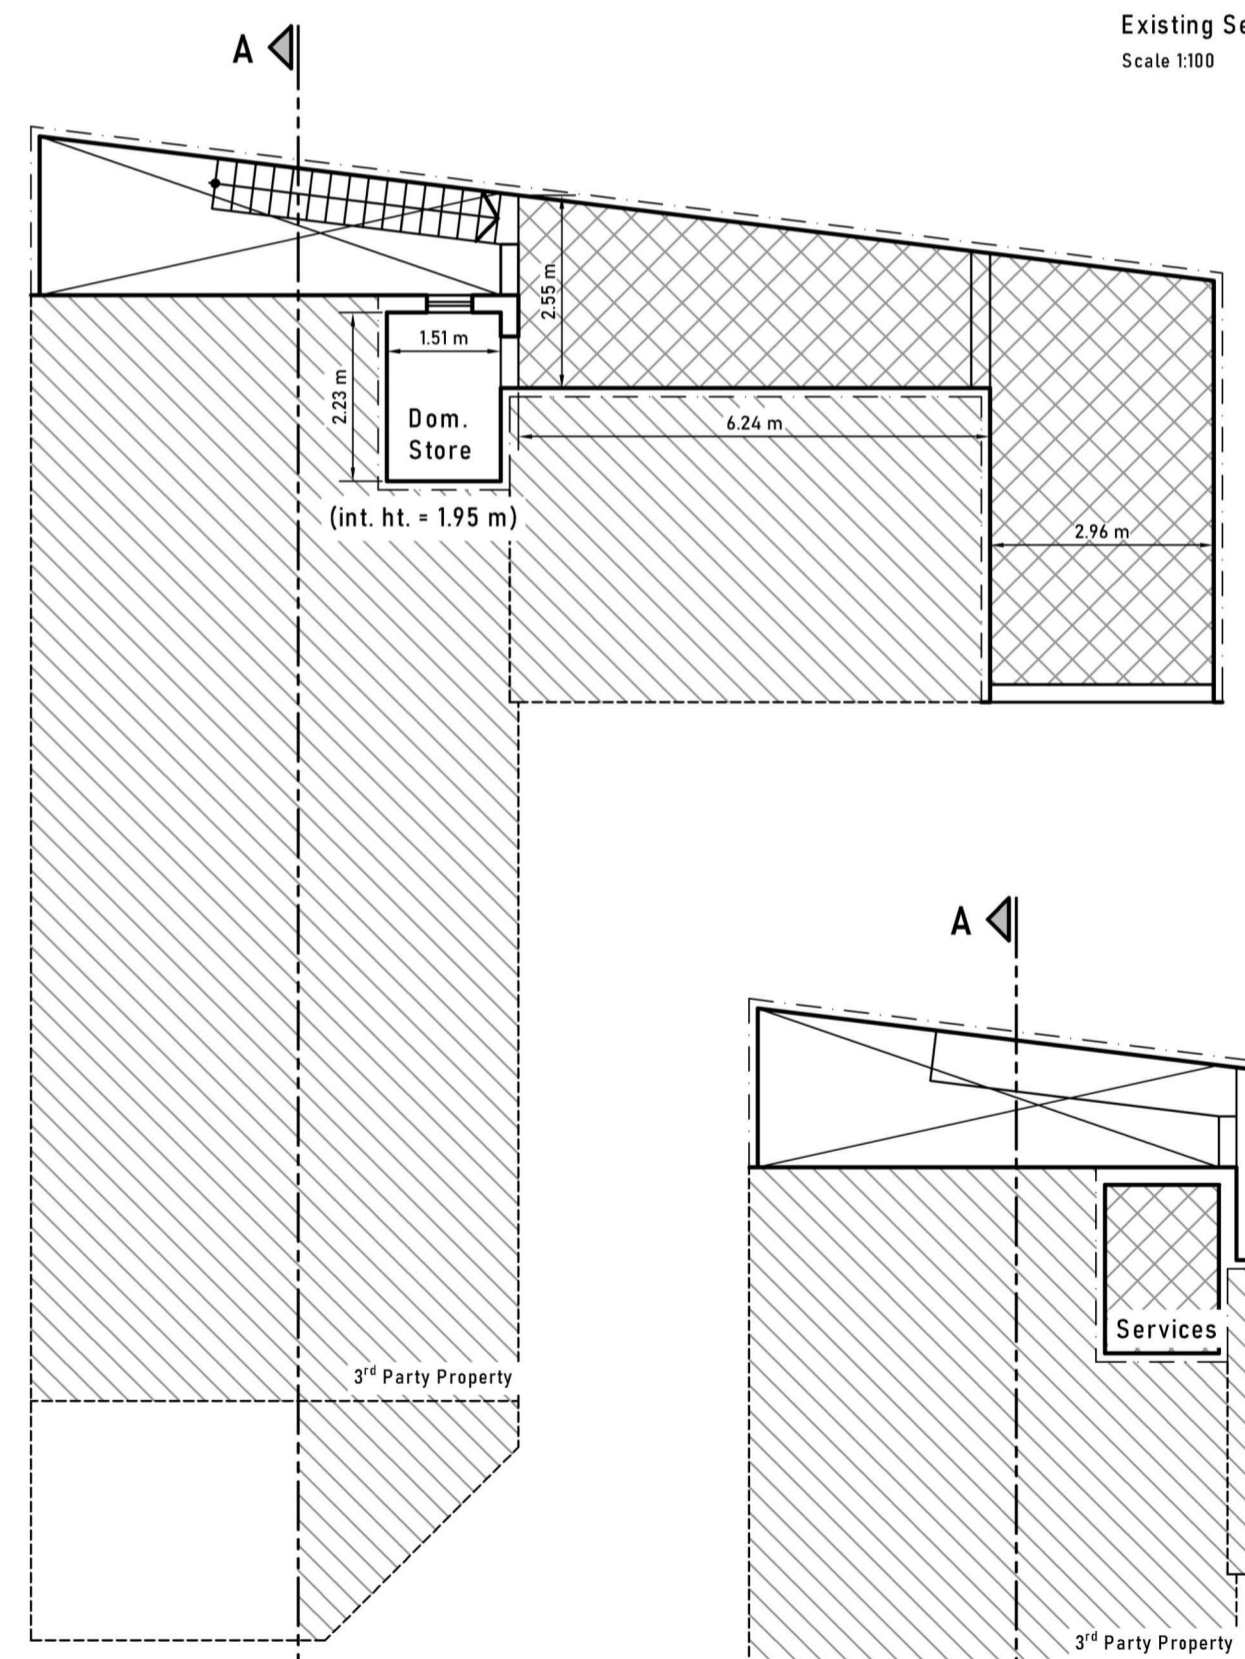

Existing First Floor Plan
Scale 1:100

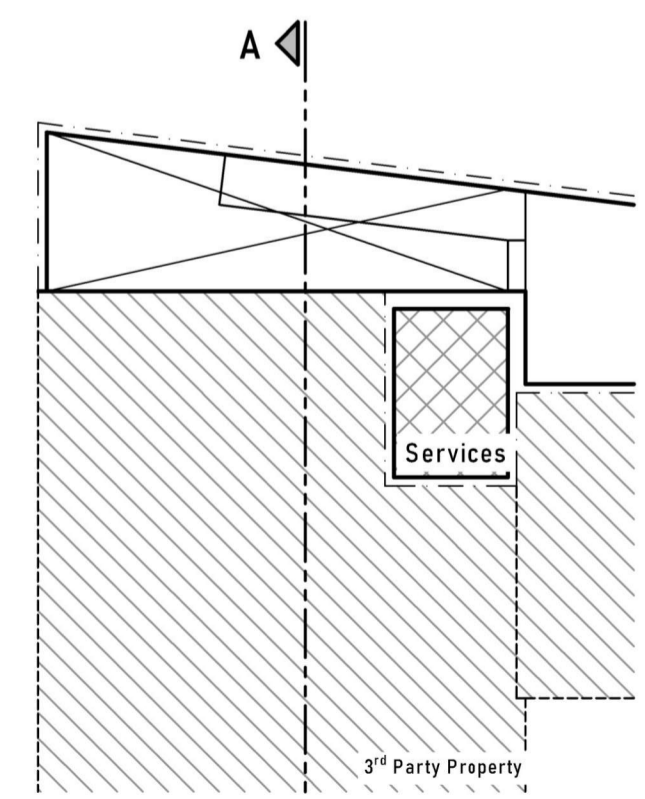

Existing Roof Plan
Scale 1:100

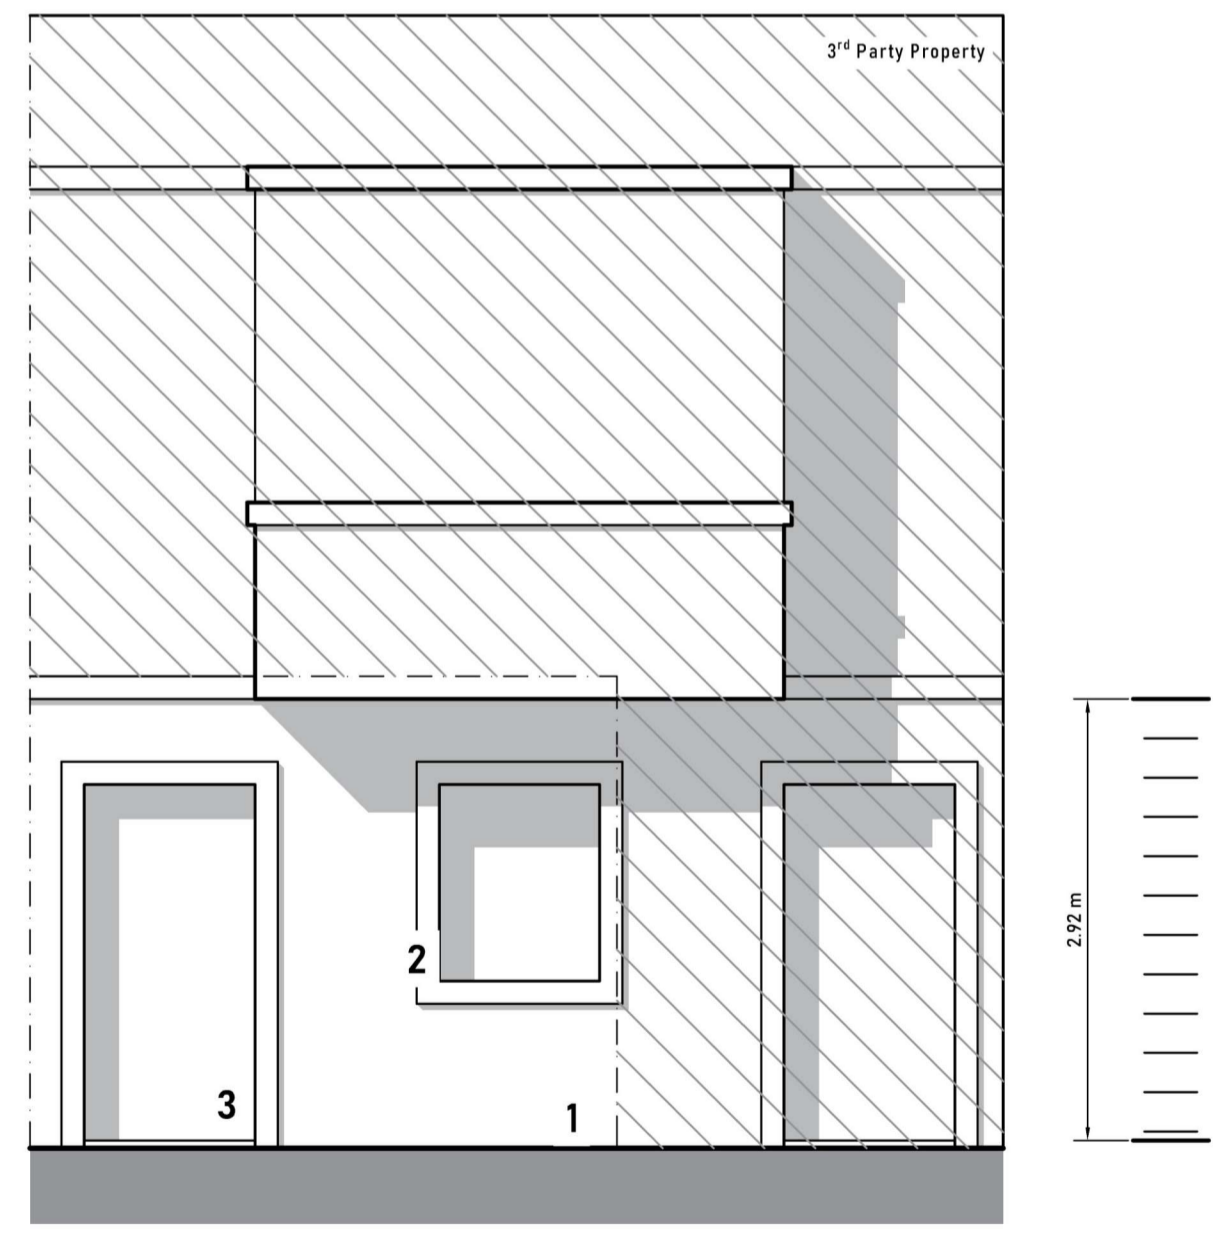

Existing Elevation
Scale 1:50

Material Legend :

- 1: Rendered Blockwork
- 2: Rendered Blockwork
- 3: Aluminium Apertures

PROJECT
TO REGULARISE GROUND FLOOR MAISONNETTE AS BUILT

SCALE BAR 1 : 50 0 1 2 3 4 5