



P11 AS BUILT/PROPOSED PENTHOUSE FLOOR PLAN
D7

Scale 1:100

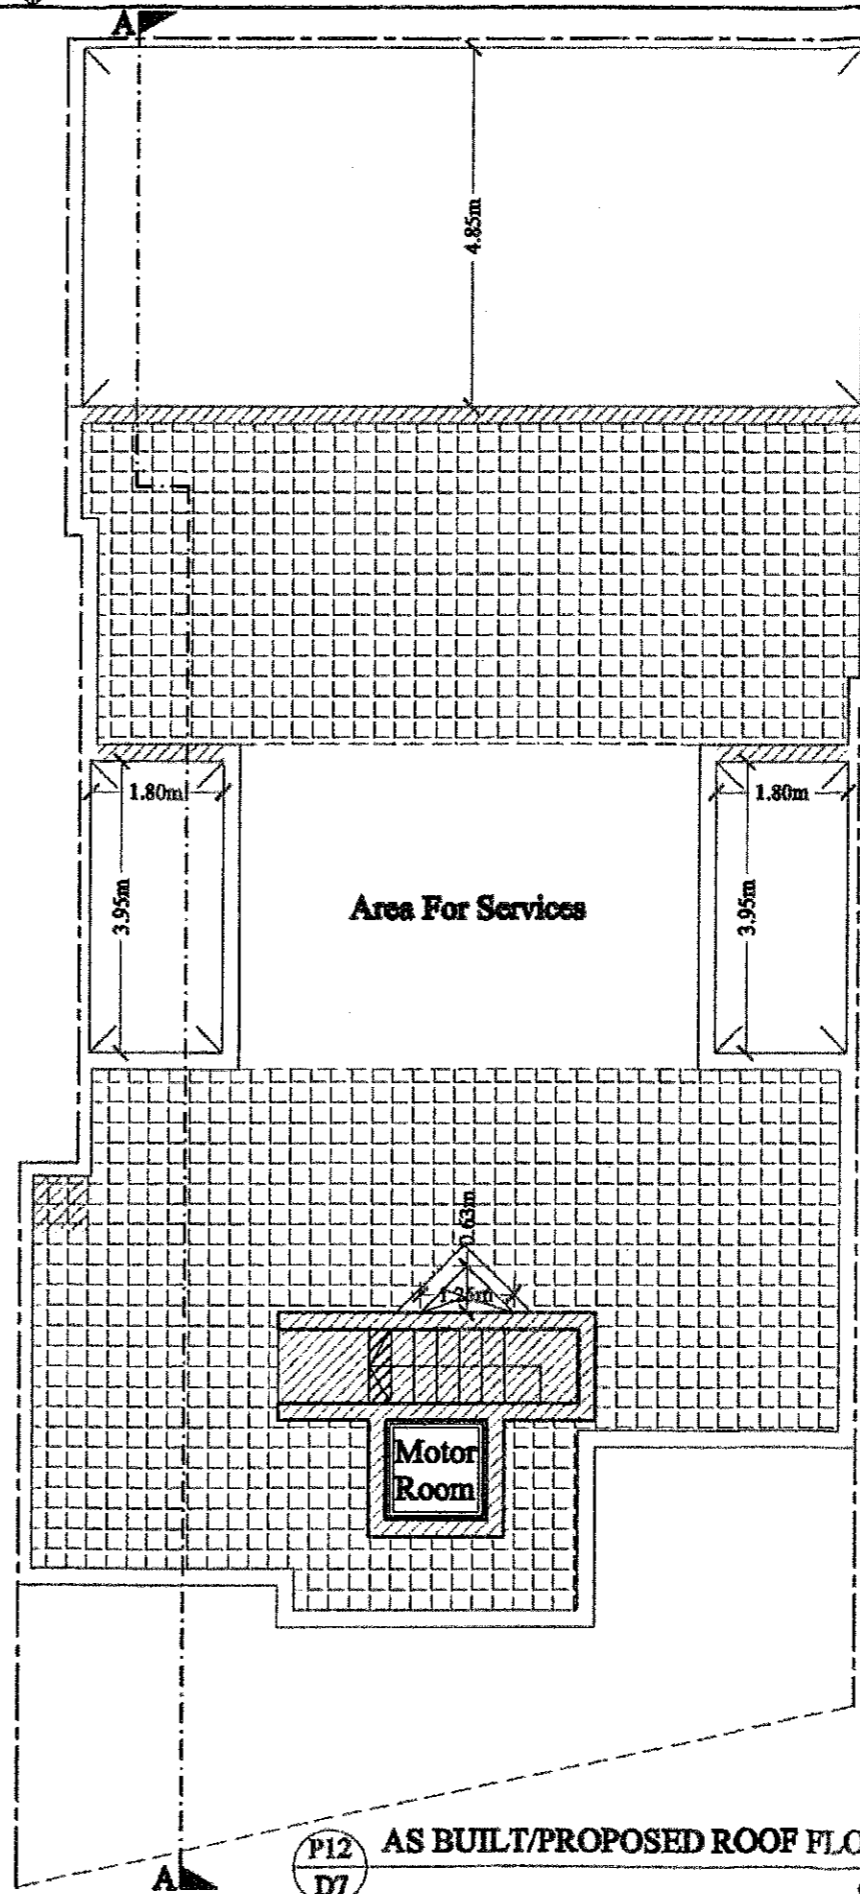

P12 AS BUILT/PROPOSED ROOF FLOOR PLAN
D7

Scale 1:100

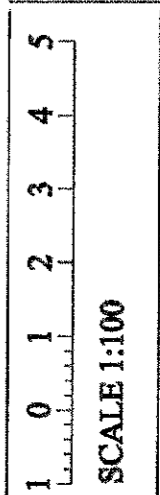

Rev:	Date:	Description:
C	JULY 2011	NCFD REQUIREMENTS
B	APR 2011	NCFD REQUIREMENTS

drawn by:	date:	des no:
S.V.	OCT 2009	112-619
approved:	scale:	deg no:
S.A.	1:200	02