


EXISTING BASEMENT PLAN

Scale 1:100

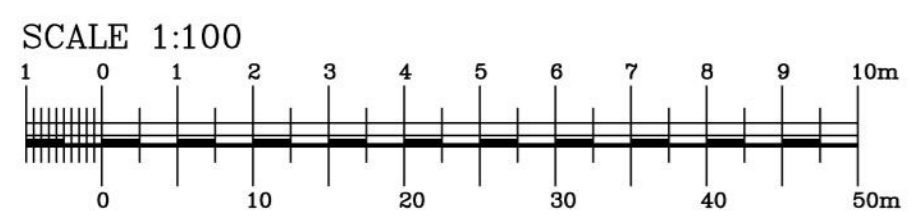

SCALE 1:500

- TO SANCTION AS BUILT
- APPROVED BUT NOT CONSTRUCTED IN PA 3540/04
- TO CONSTRUCT
- TO DEMOLISH

EXISTING BASEMENT PLAN

Scale 1:100

CLEAN COPY