



Scale - 1:100

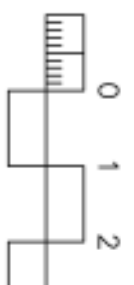


Scale - 1:50

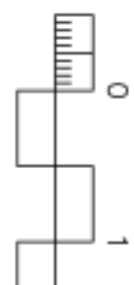

- FINISHES:**
- 1. Exposed masonry walls.
  - 2. Masonry with Imbroil Finish.
  - 3. H.C.B. rendered in light color.
  - 4. Galvanised steel garage door.

FRONT ELEVATION (1:50)  
As built

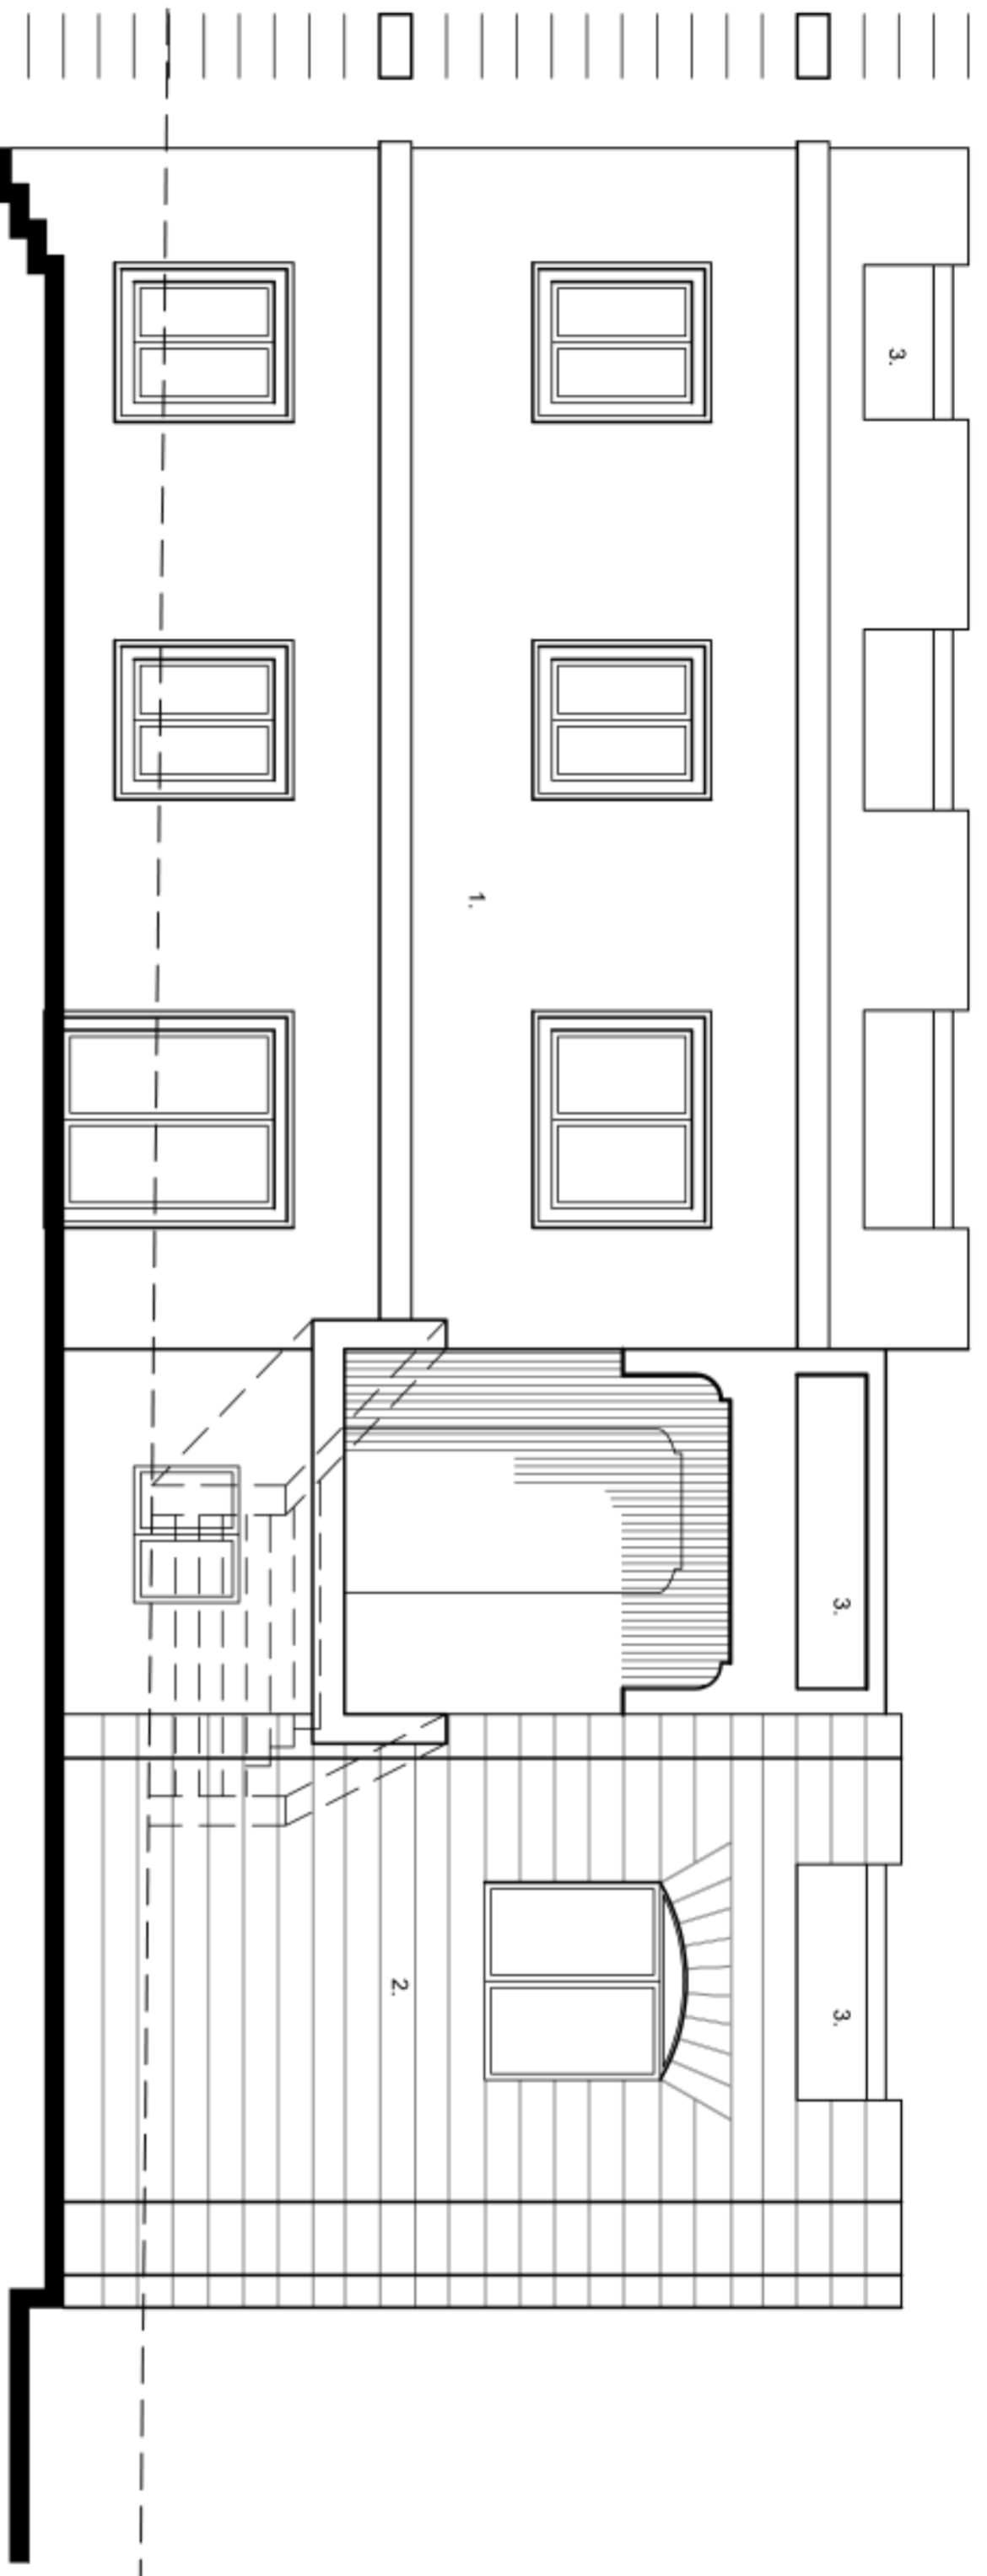

SIDE ELEVATION (1:50)  
As built

