



Approved Basement -1

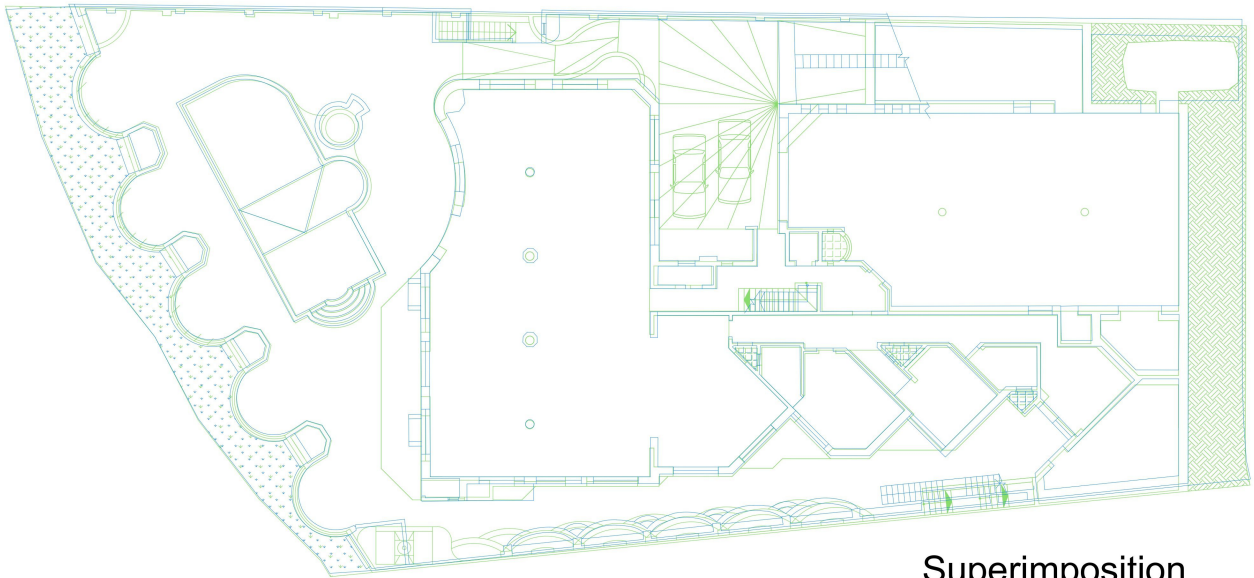

Superimposition

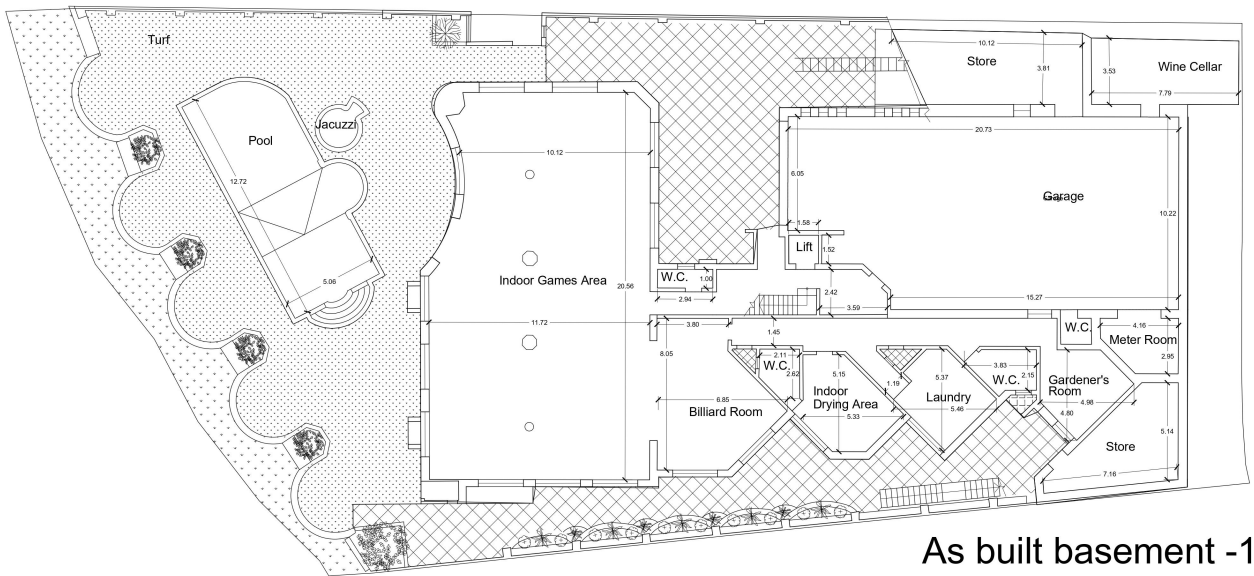

As built basement -1