




Copyright © AP VALLETTA and AP VALLETTA LTD. All rights reserved. This document has been authored by AP VALLETTA and AP VALLETTA LTD and it is protected by copyright owned by its authors. No part of this document may be reproduced, stored in a retrieval system or transmitted in any form or by any means, electronic, mechanical, photocopying, recording or otherwise, without the previous written permission of the author. Whilst the authors have exercised reasonable skill and care in producing this document, its accuracy cannot be guaranteed, particularly where reliance has been placed upon the sufficiency and correctness of information provided by others.

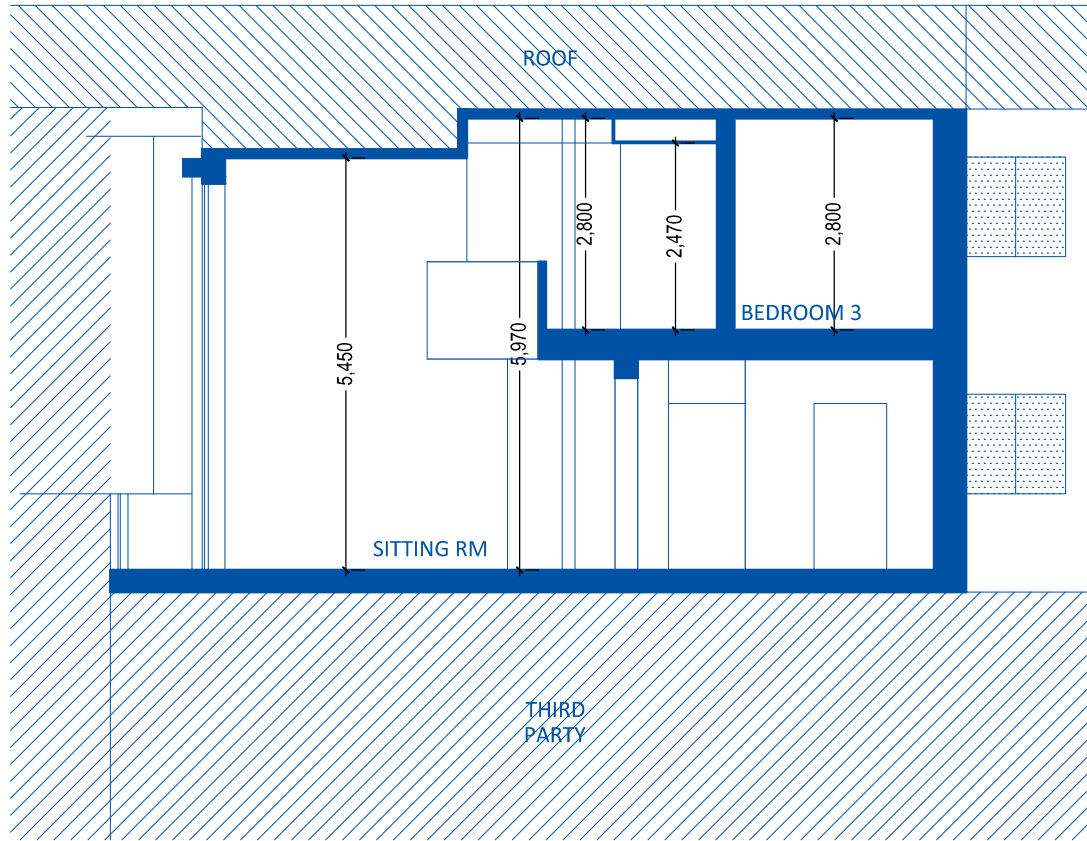

A SECTION A - AS CONSTRUCTED
SCALE 1:100

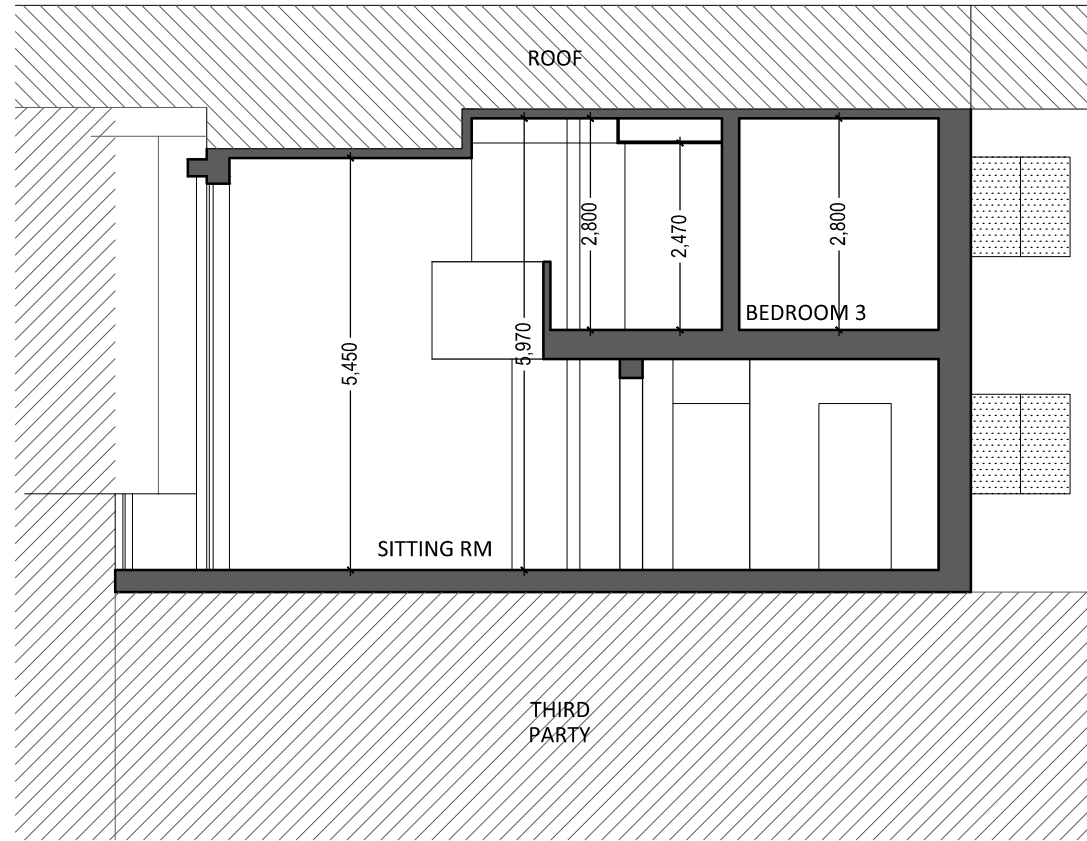

B SECTION A - CLEAN COPY
SCALE 1:100

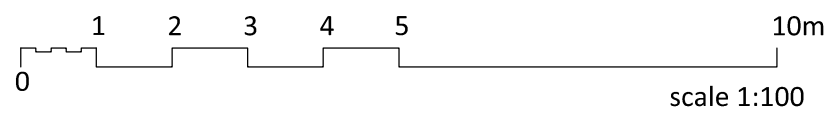

LEGEND

	TO SANCTION AS BUILT
	APPROVED & NOT BUILT

project	DUPLEX PENTHOUSE AT MILNER GROVE - SANCTIONING OF DISCREPANCIES
address	AMBER 14, TRIO GHAR ID-DUJD, SUEMA
drawing	SECTION - AS CONSTRUCTED & CLEAN COPY
diag no.	C 0 0 9 2 2 . 0 0 1 0 1 P A 3 0 0
rev. no.	REV. -
drawn	SS
checked by	DF
date	08MAR23
scale	1:100 @ A3
revisions	
ref. date	
by	
description	

AP Valletta Ltd. | 4 sappers street
valletta | vlt 1320 | malta
tel. +356 2124 3981
info@apvalletta.eu | www.apvalletta.eu

