

2
3
4
5
7
10
1:100
THIS DRAWING IS THE COPYRIGHT OF KOBELAND MAY NOT BE RETAINED, REPRODUCED, STORED IN A RETRIEVAL SYSTEM OR TRANSMITTED IN ANY FORM OR BY ANY MEANS WITHOUT PRIOR PERMISSION

007
C

007
C

E
008

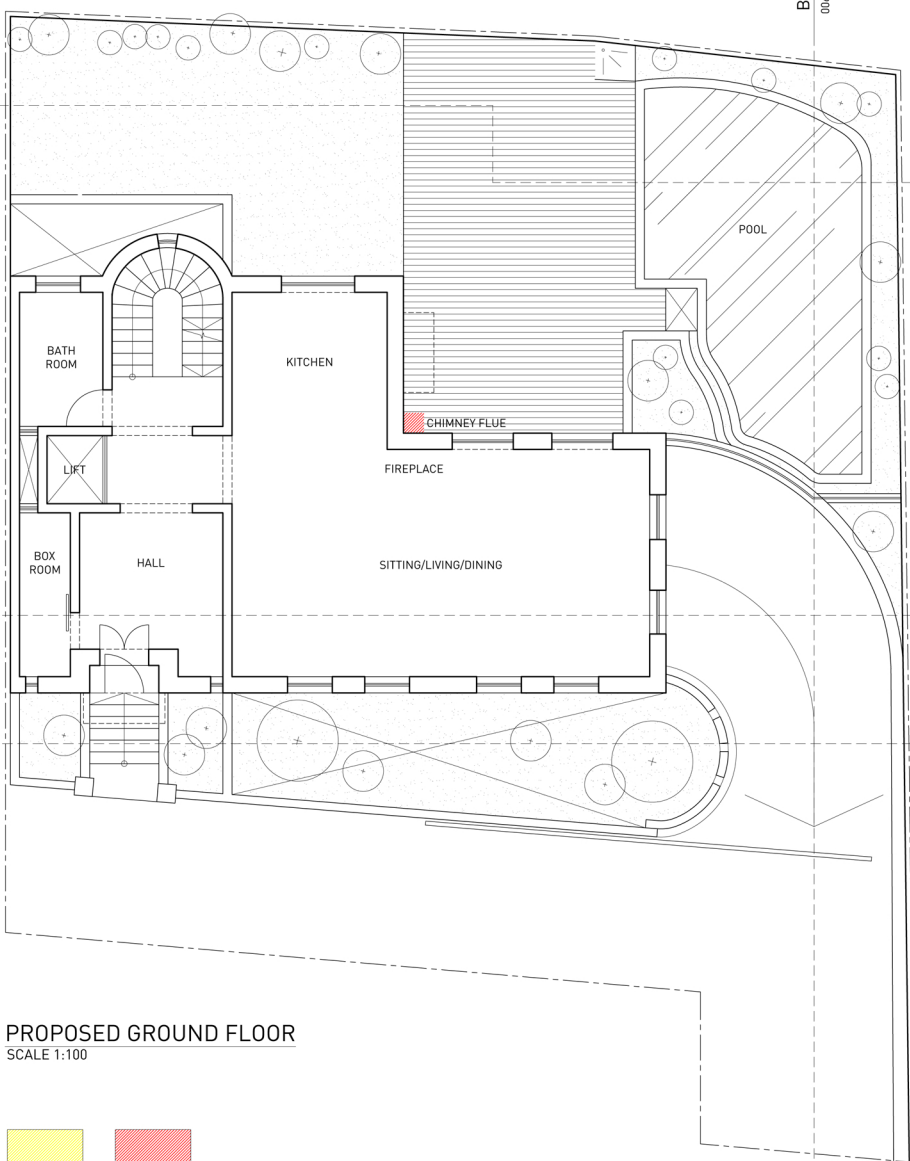
E
008

A
005

A
005

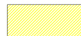



B
006

B
006



PROPOSED GROUND FLOOR

SCALE 1:100

	
DEMOLISH	BUILD
	
AS CONSTRUCTED	AS APPROVED BUT NOT BUILT