




SCALE 1:100

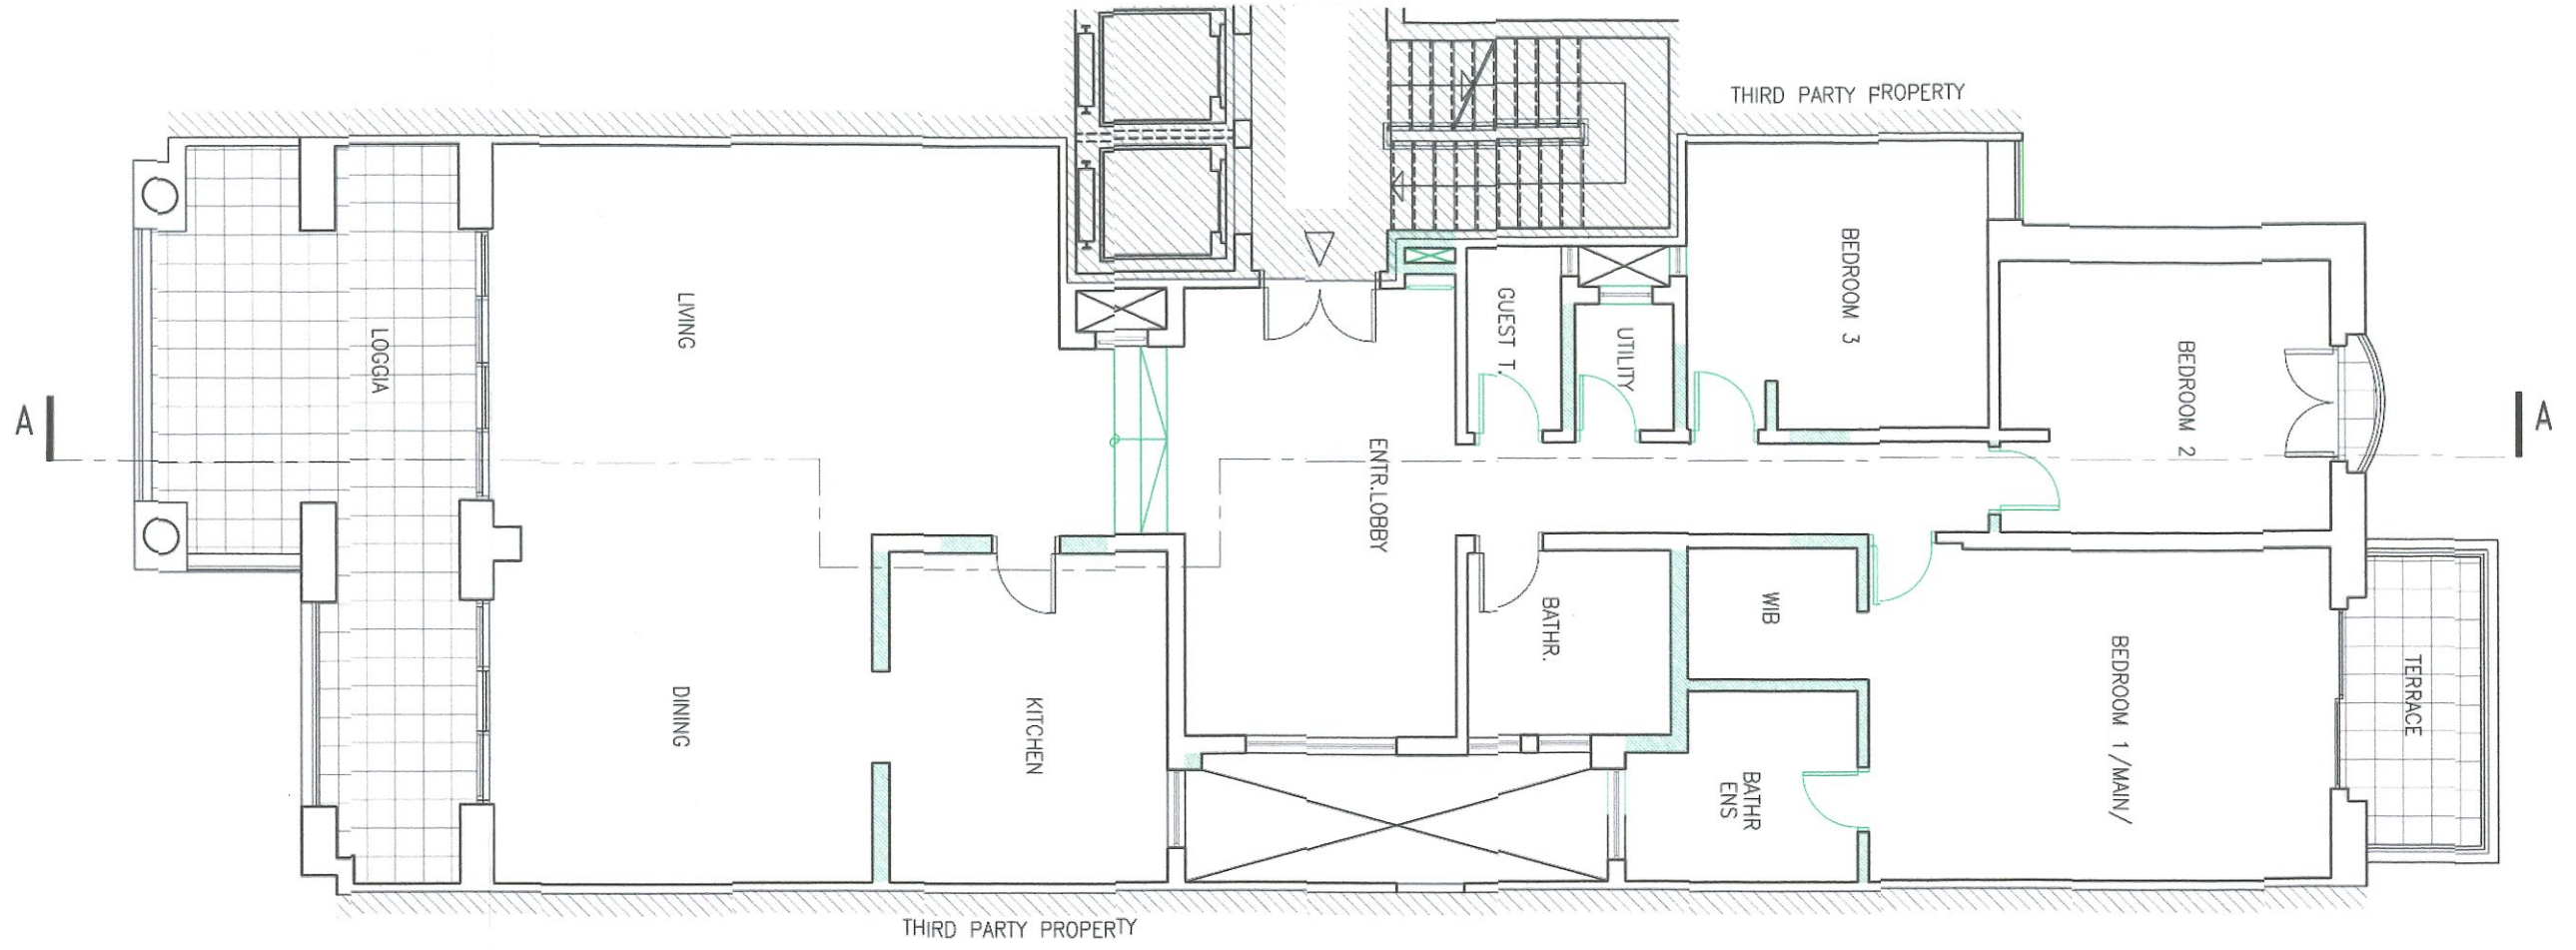

2
PA.01 SCALE 1:100

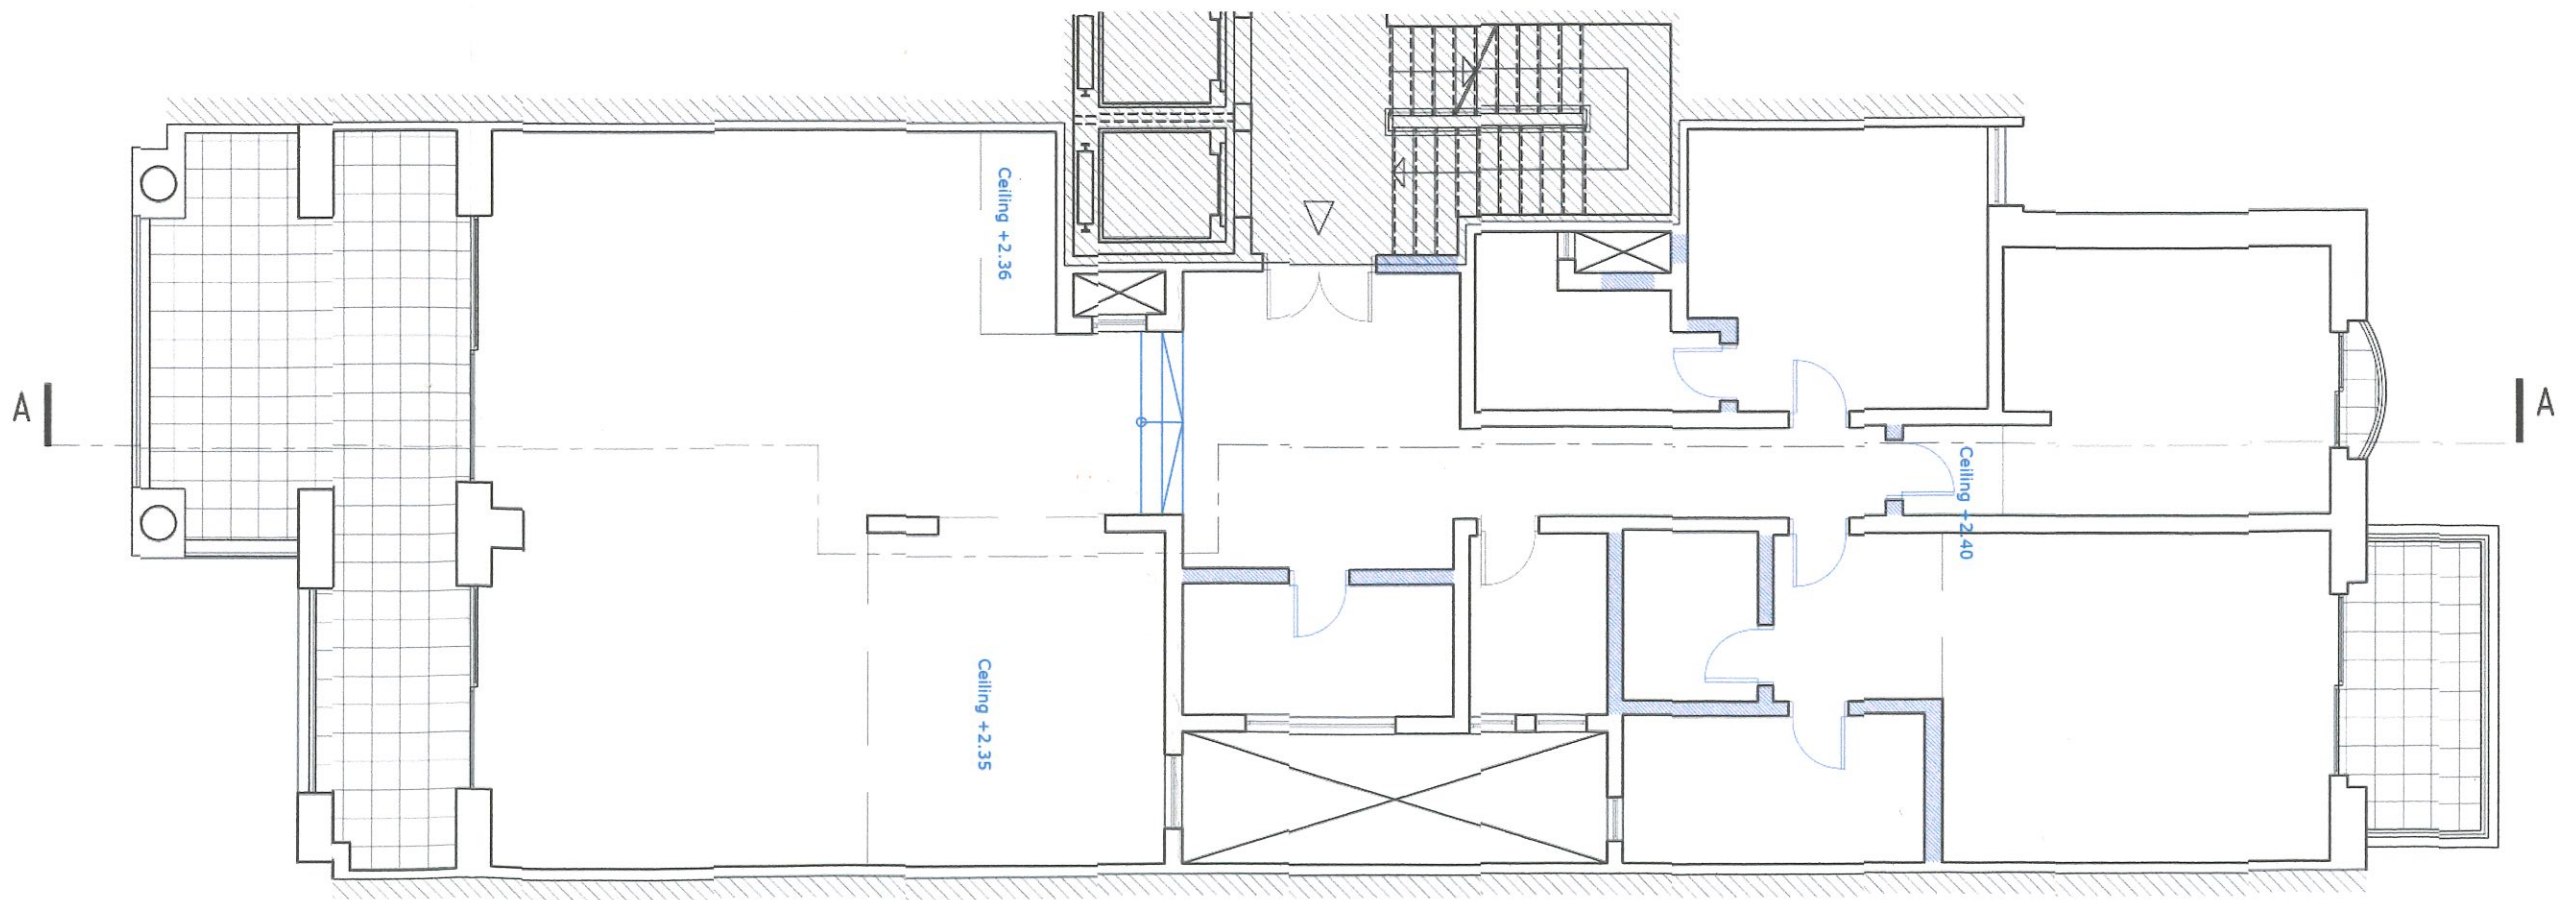


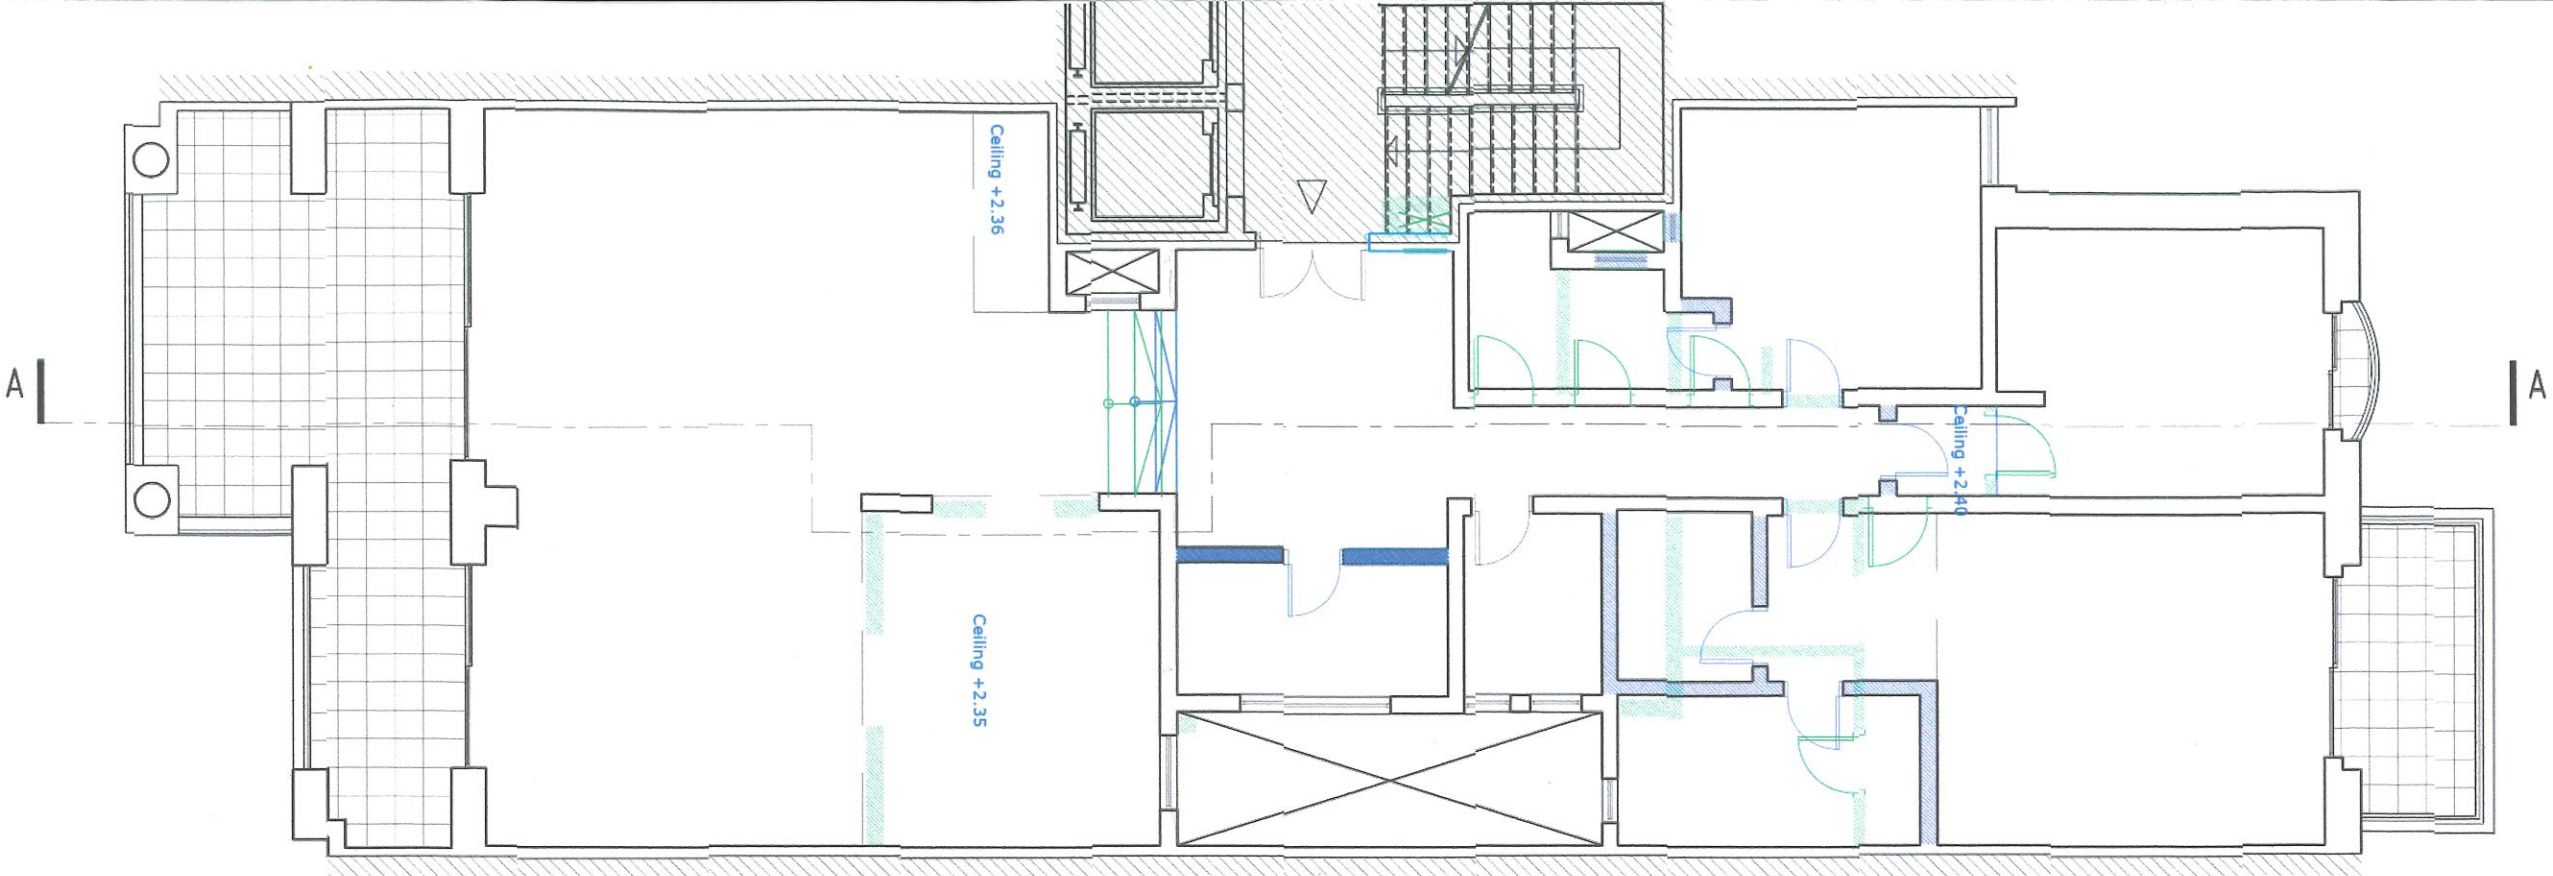

A

3 SUPERIMPOSED

SCALE 1:100

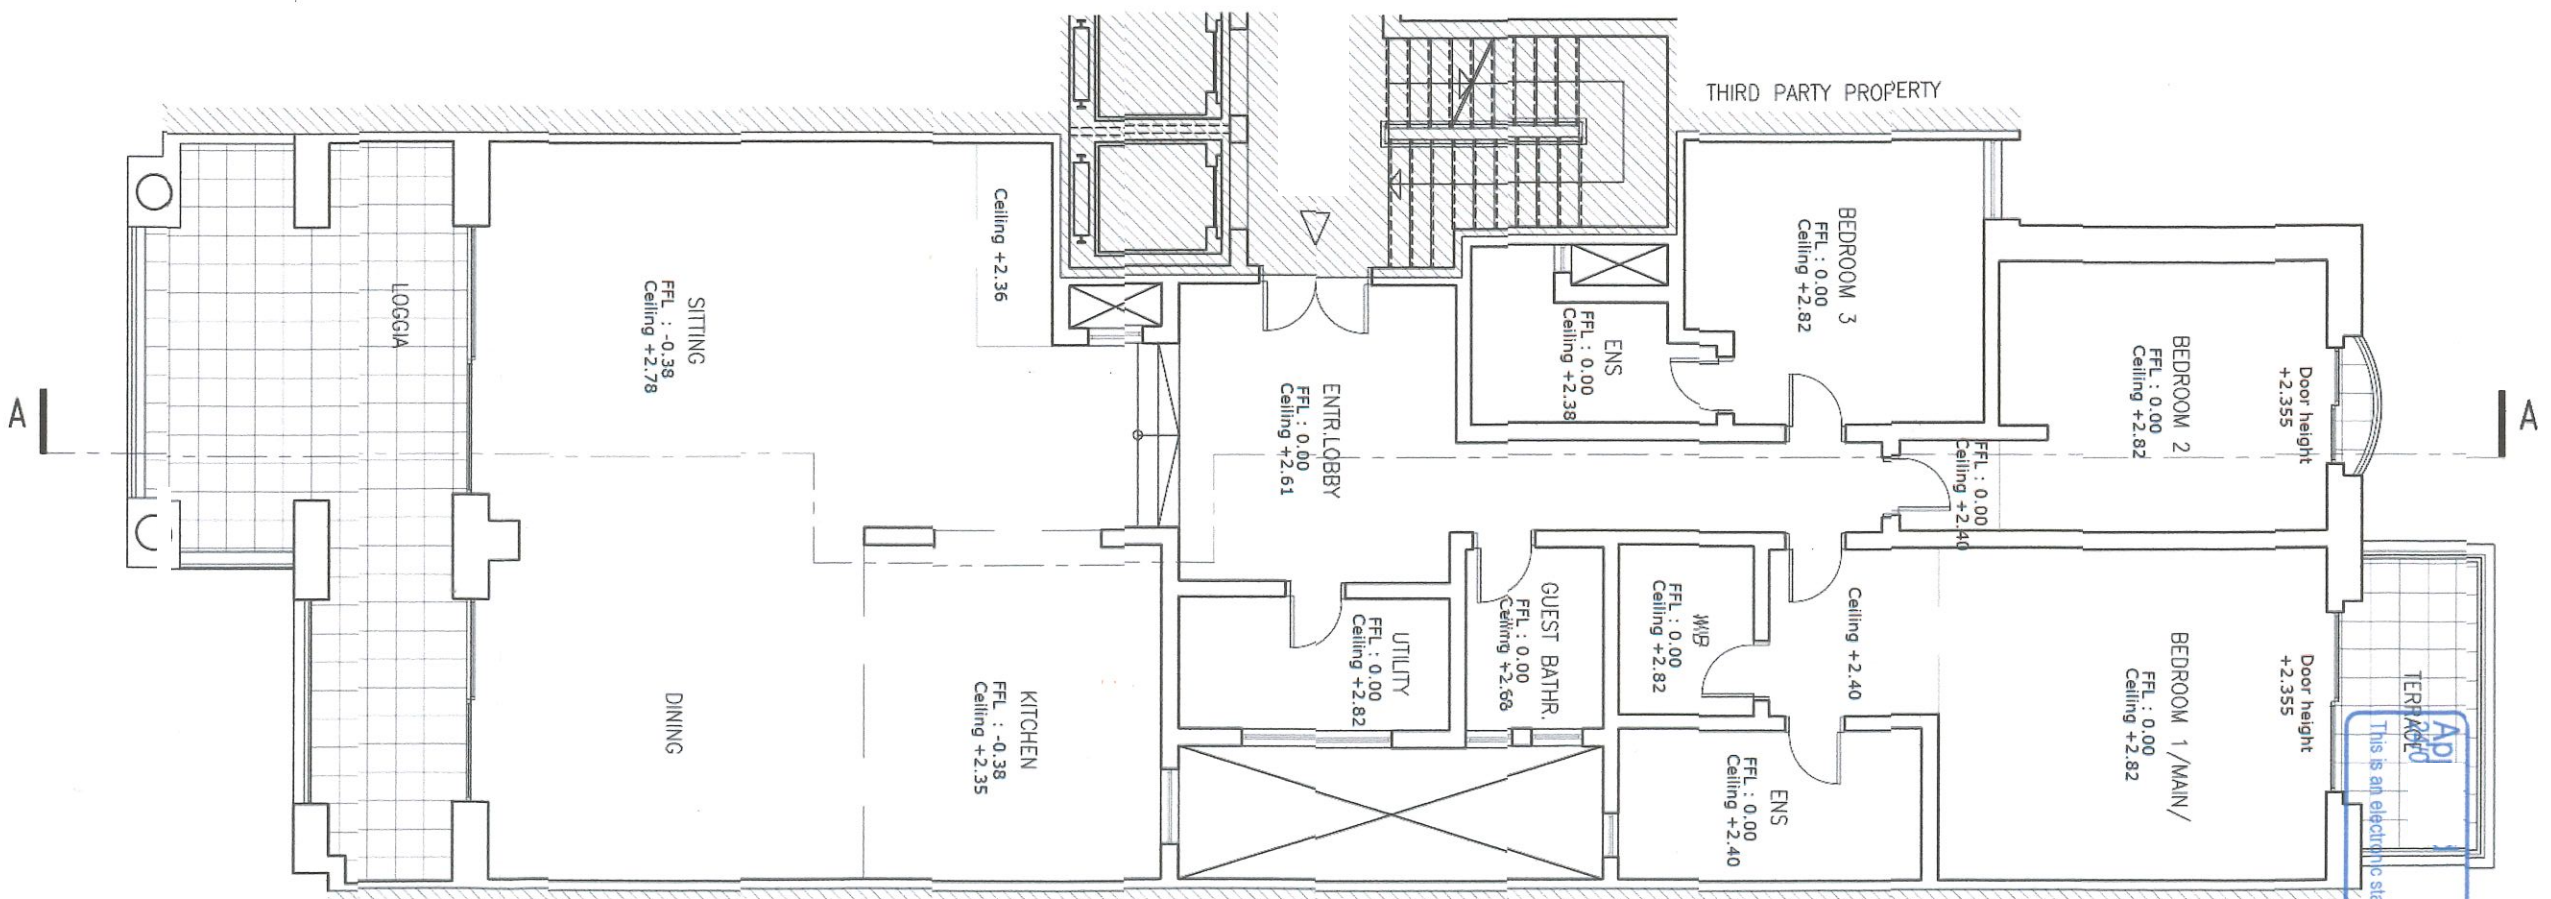



A



4 LEVEL 7 PLAN_CLEAN

SCALE 1:100

AS APPROVED BUT NOT CONSTRUCTED

AS CONSTRUCTED BUT NOT APPROVED

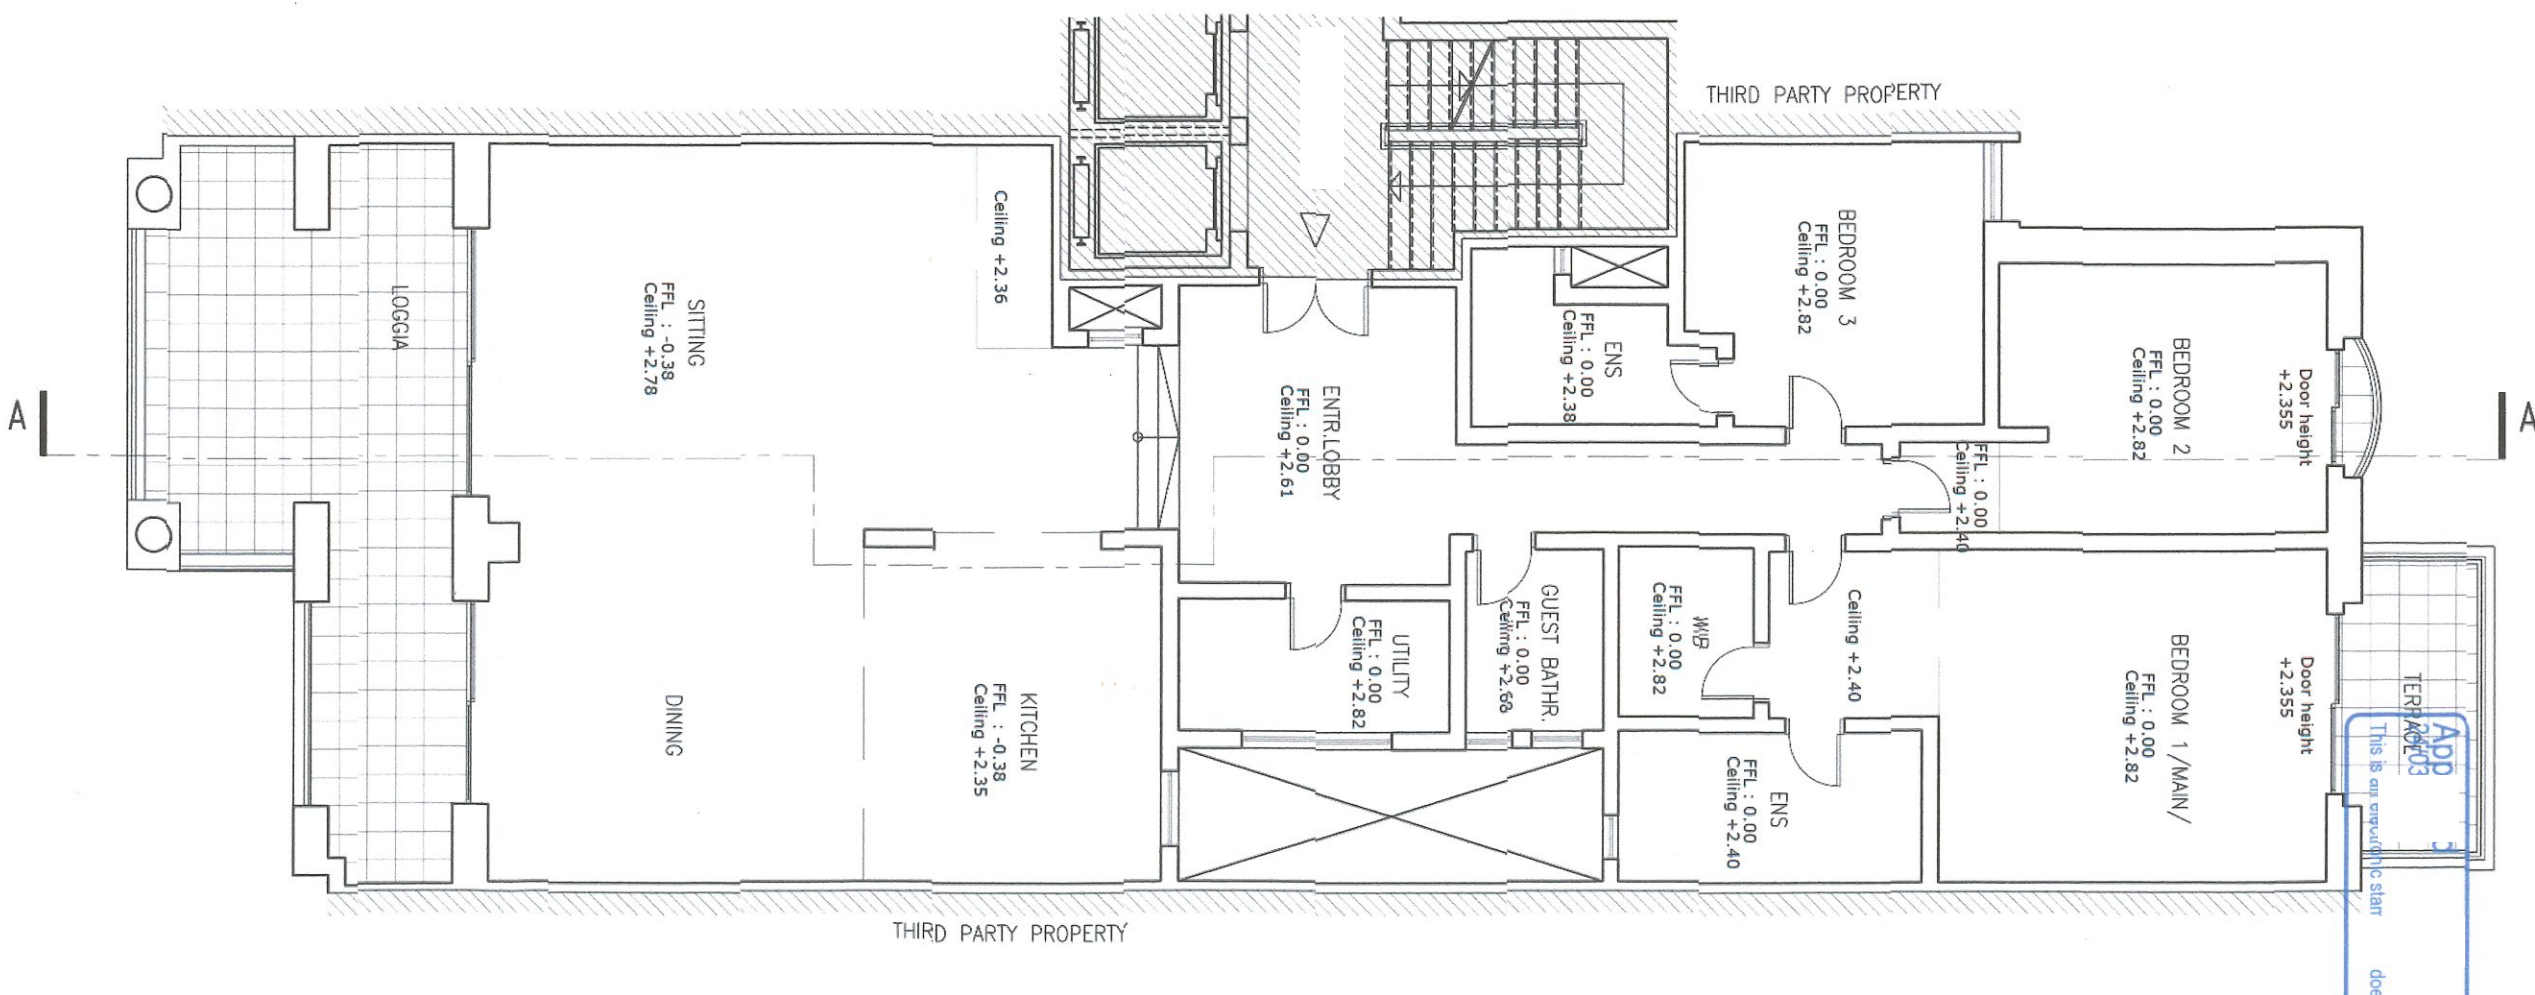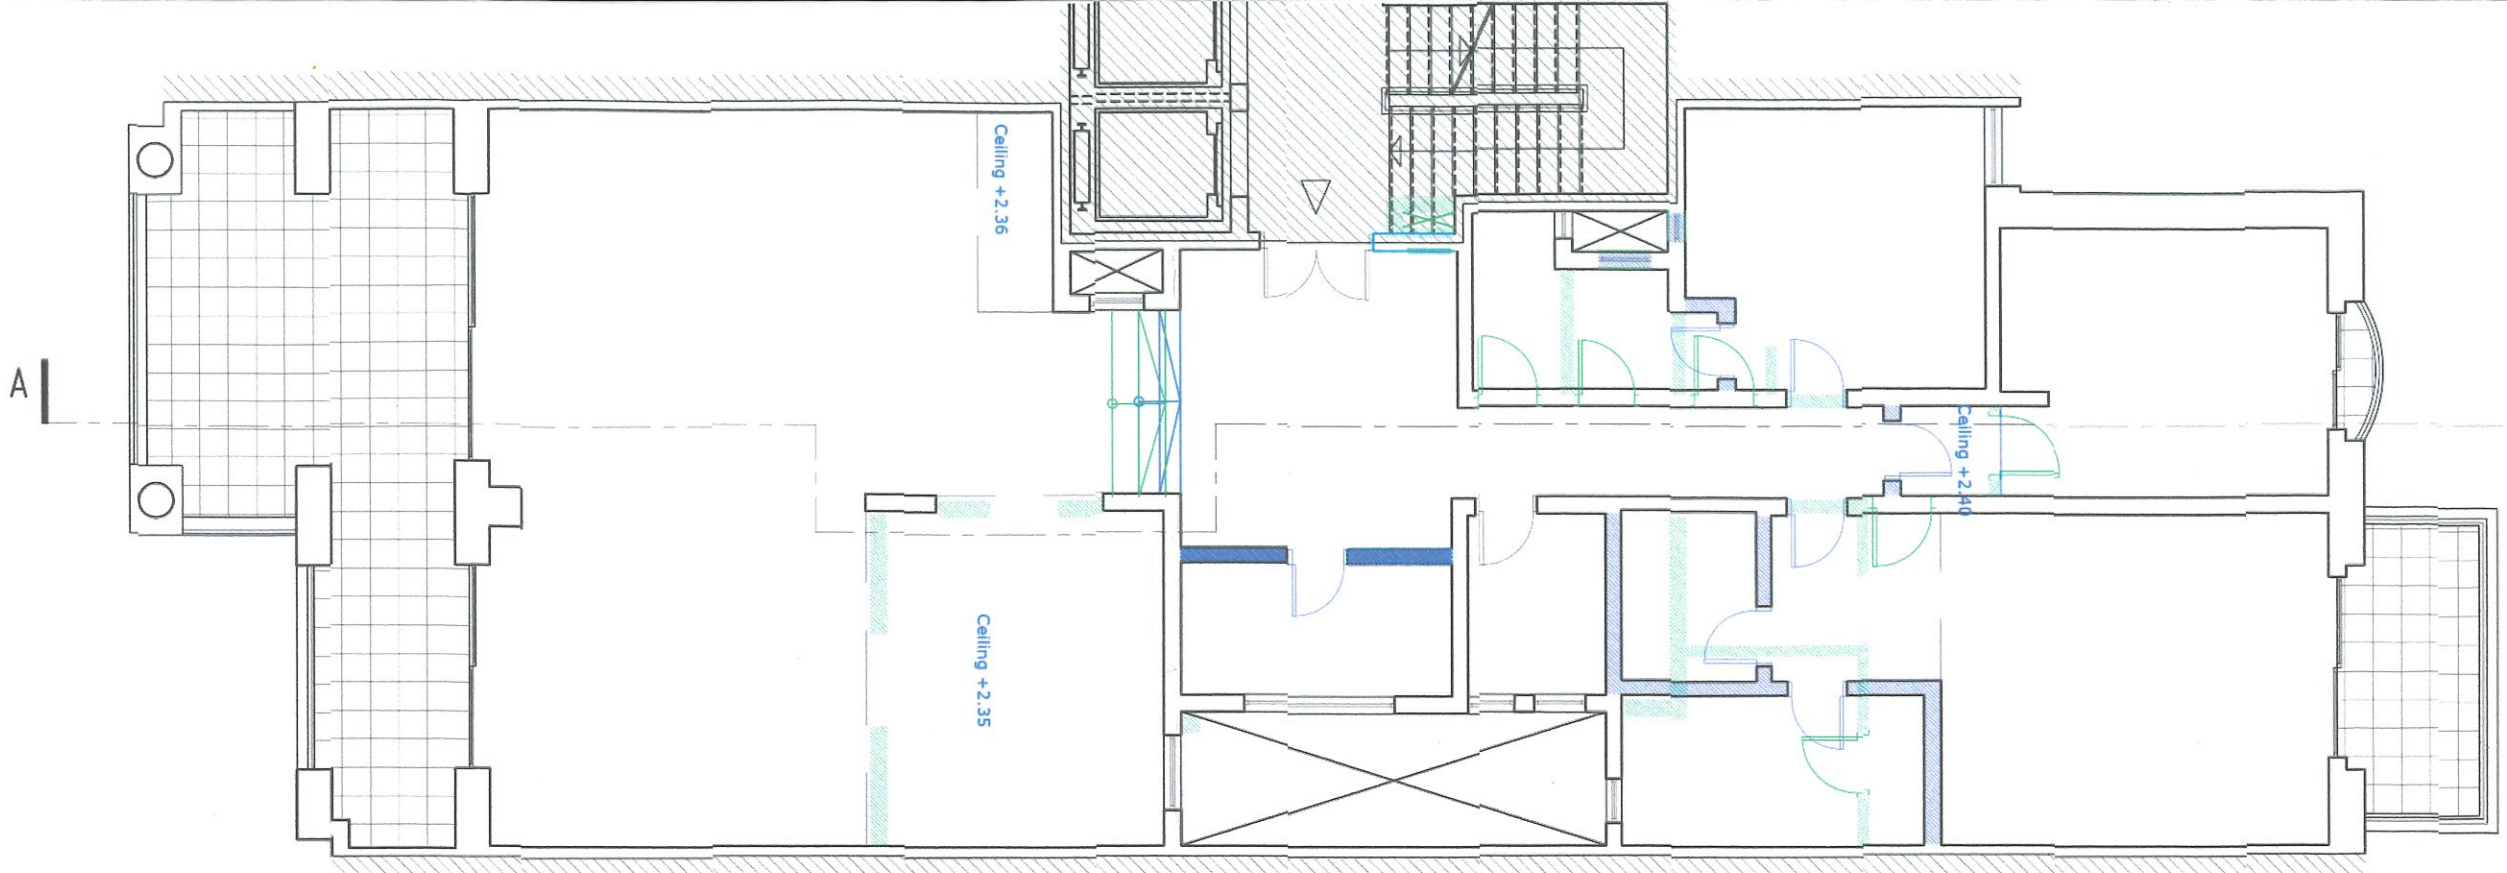

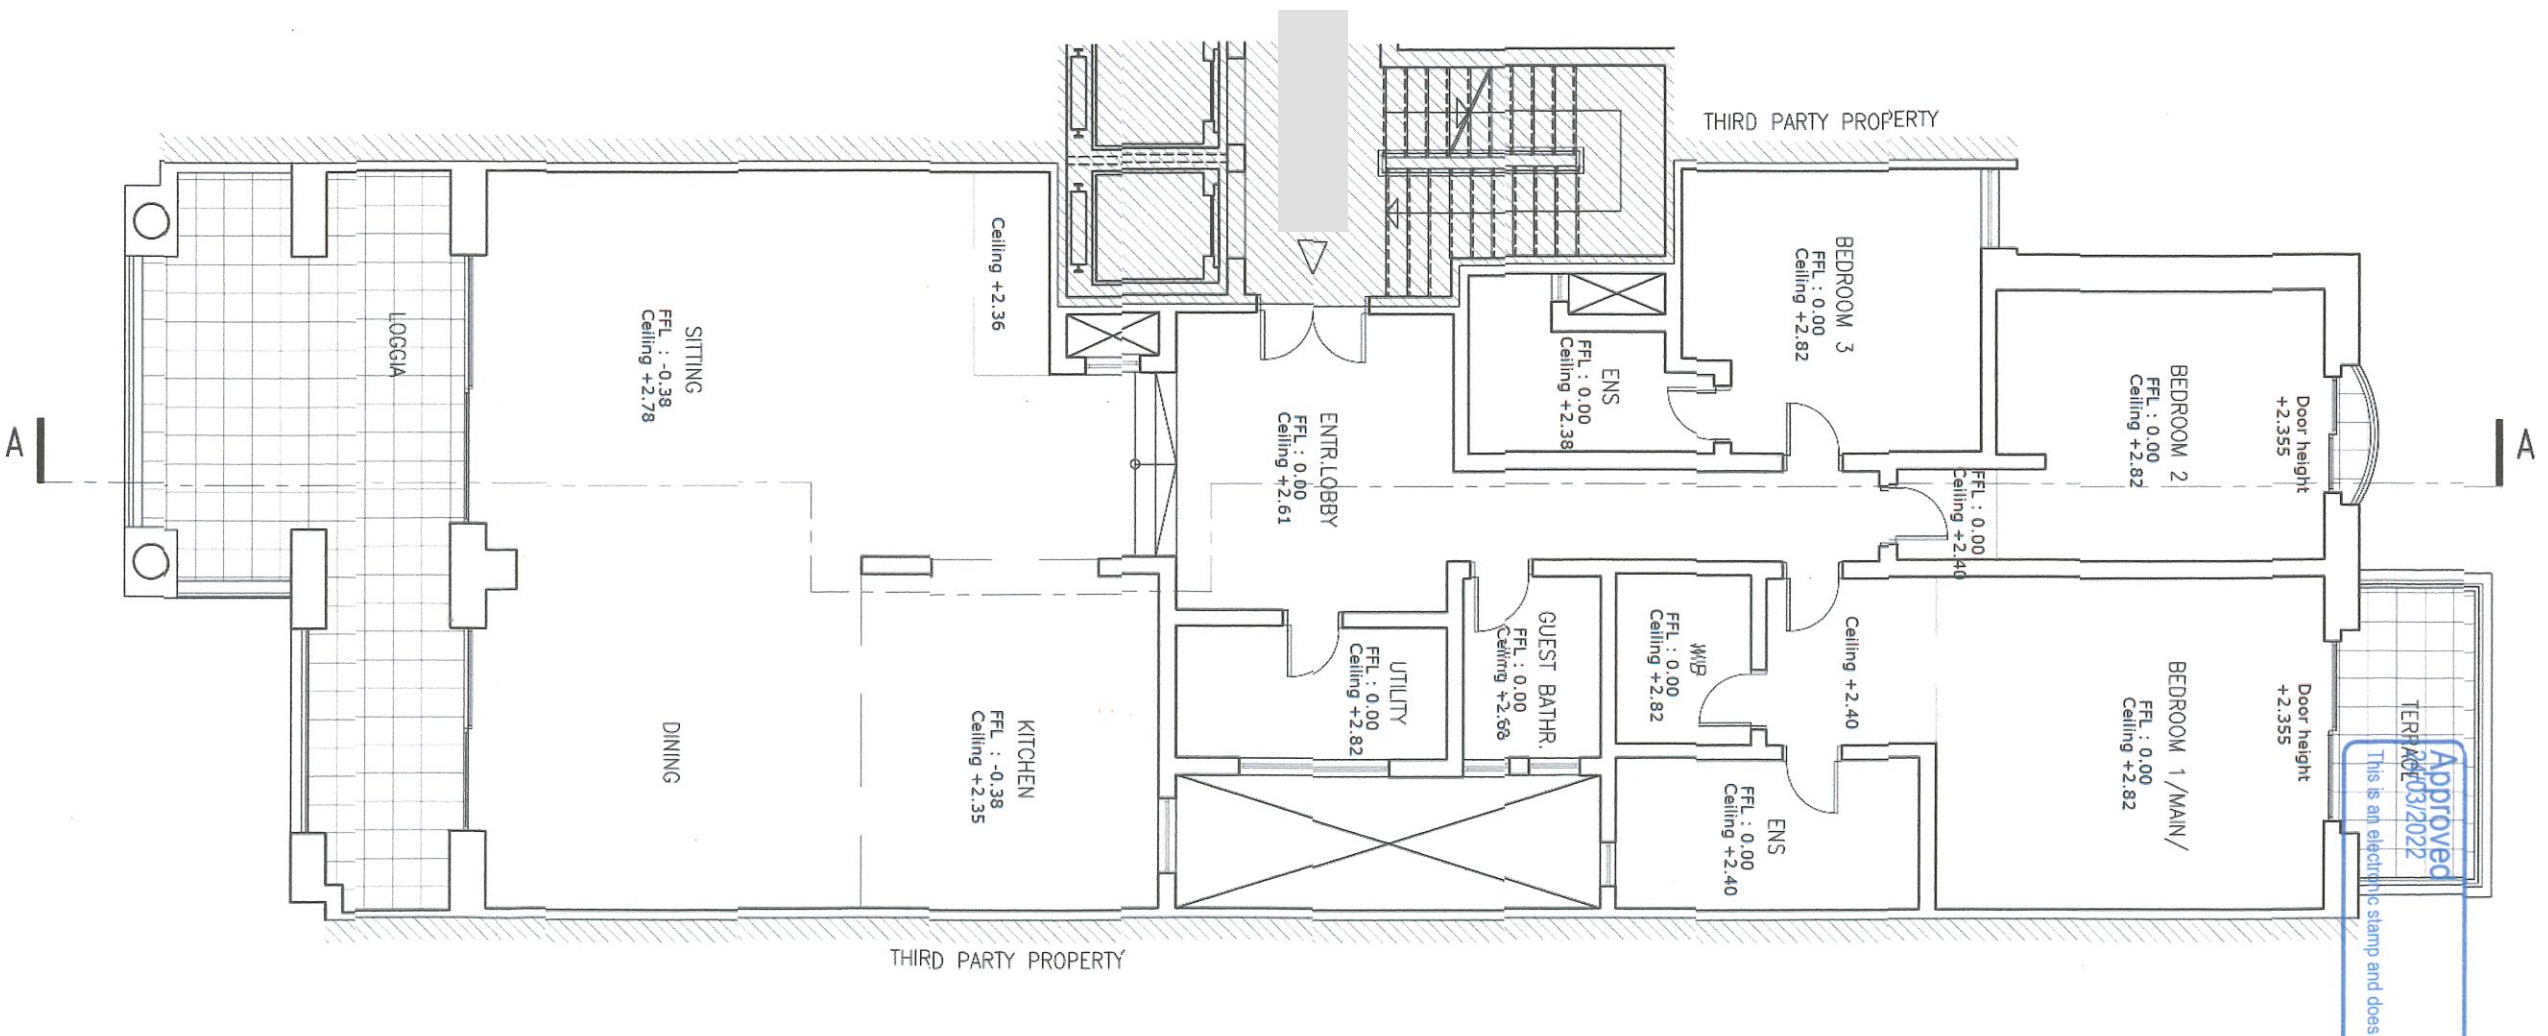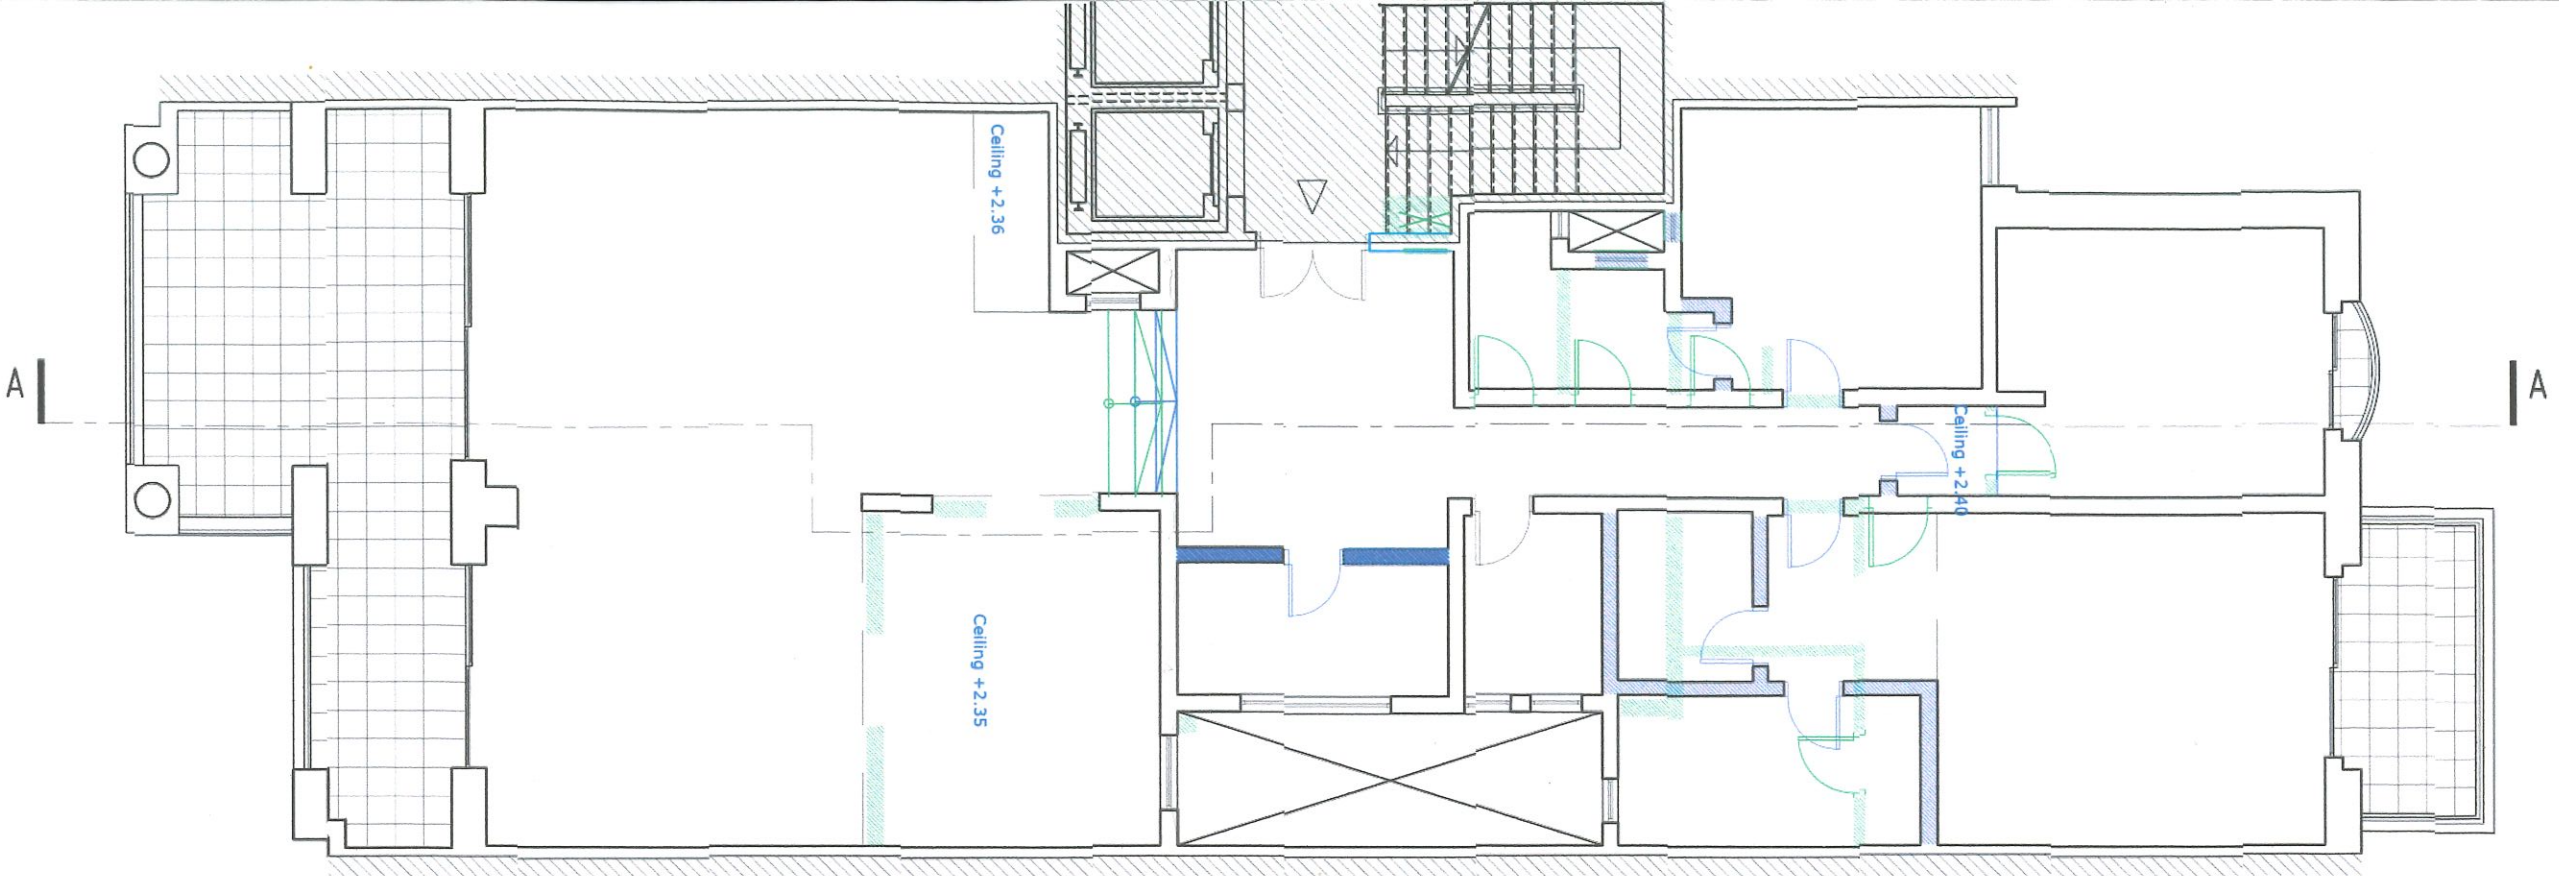

3 SUPERIMPOSED

SCALE 1:100

4

SCALE 1:100

AS APPROVED BUT NOT CONSTRUCTED

AS CONSTRUCTED BUT NOT APPROVED