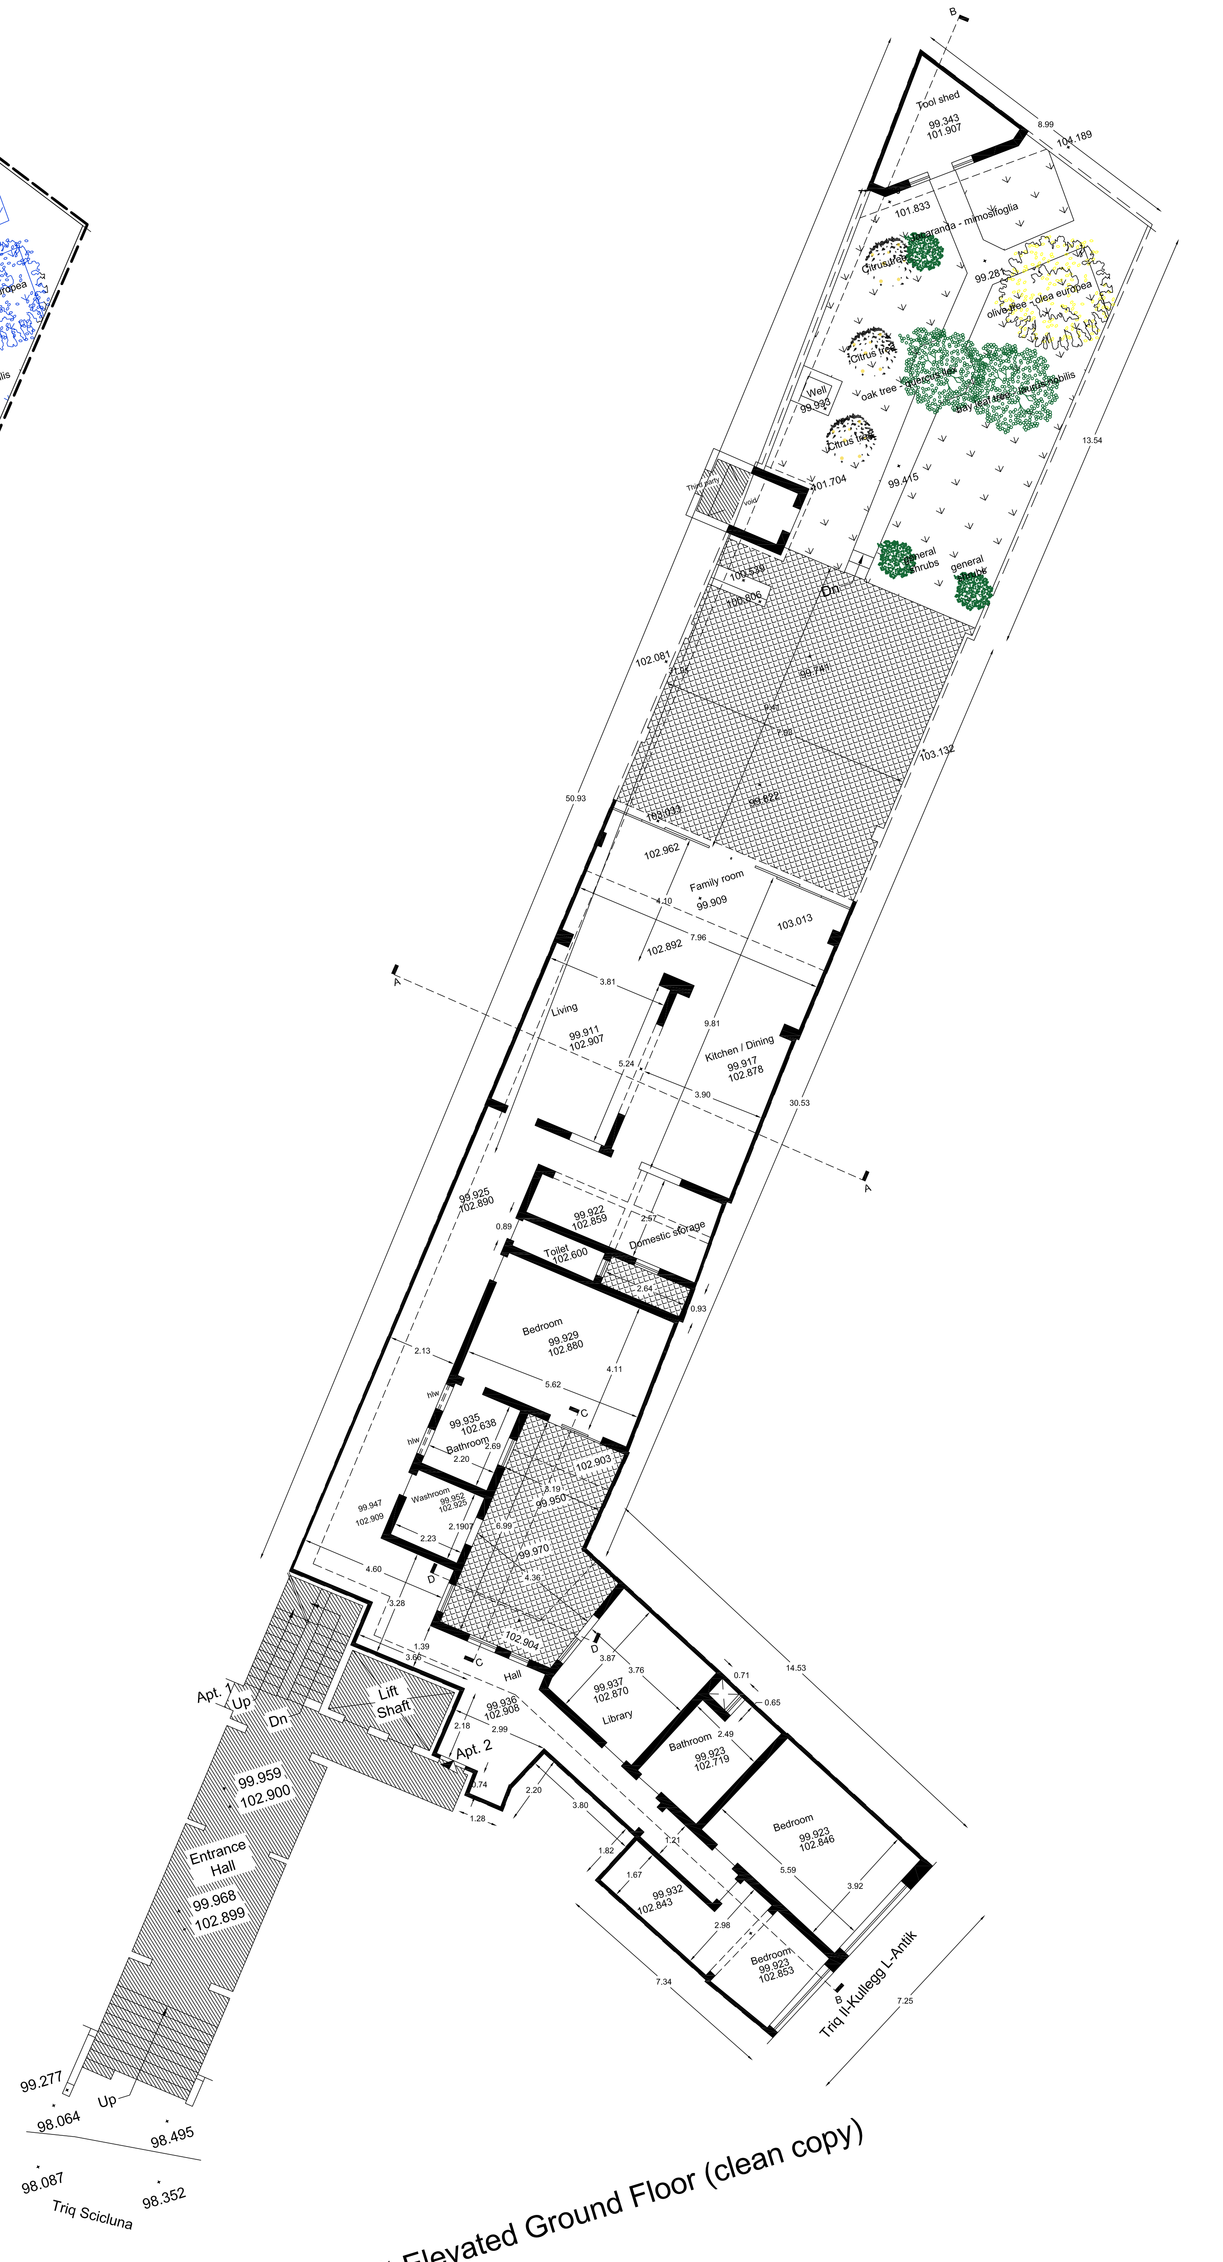

As built Elevated Ground Floor (clean copy)

METRES 1 0 1 2 3 4 5 6 7 8 9 10

FEET 10 0 10 20 30

SCALE 1:100