0 1 2 4 6 8 10M

SCALE 1:100

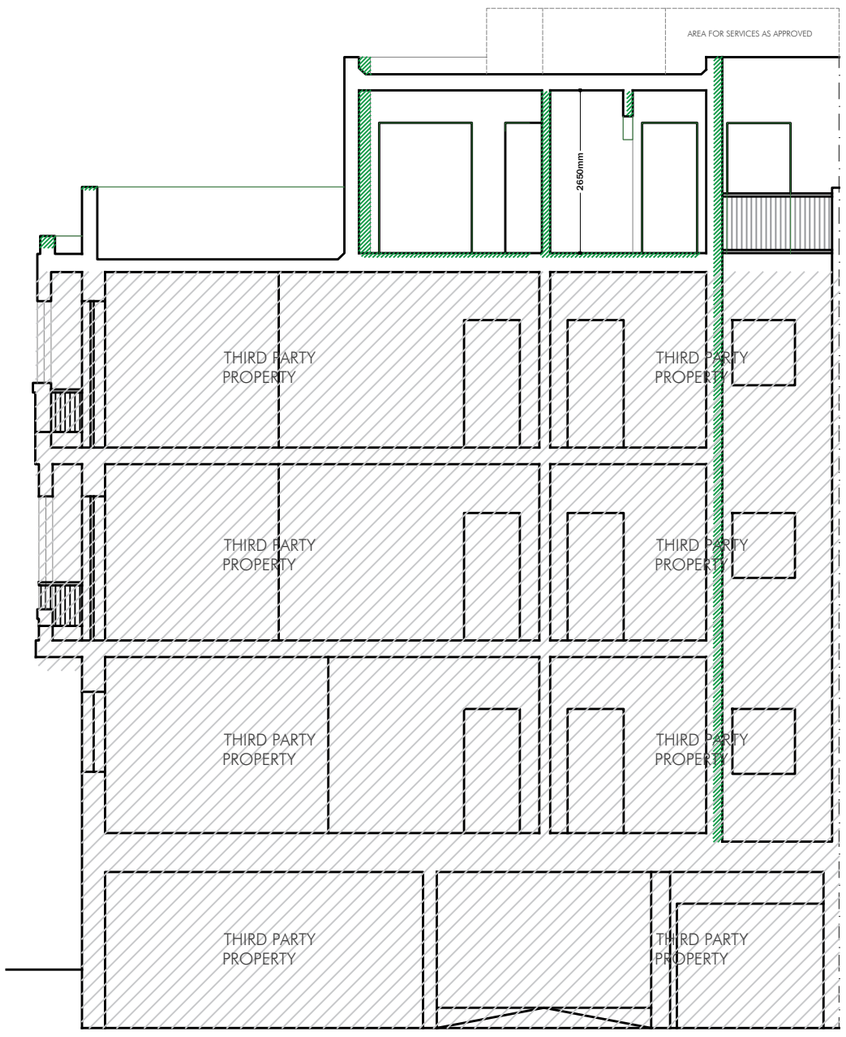

APPROVED SECTION B-B'
SCALE: 1:100

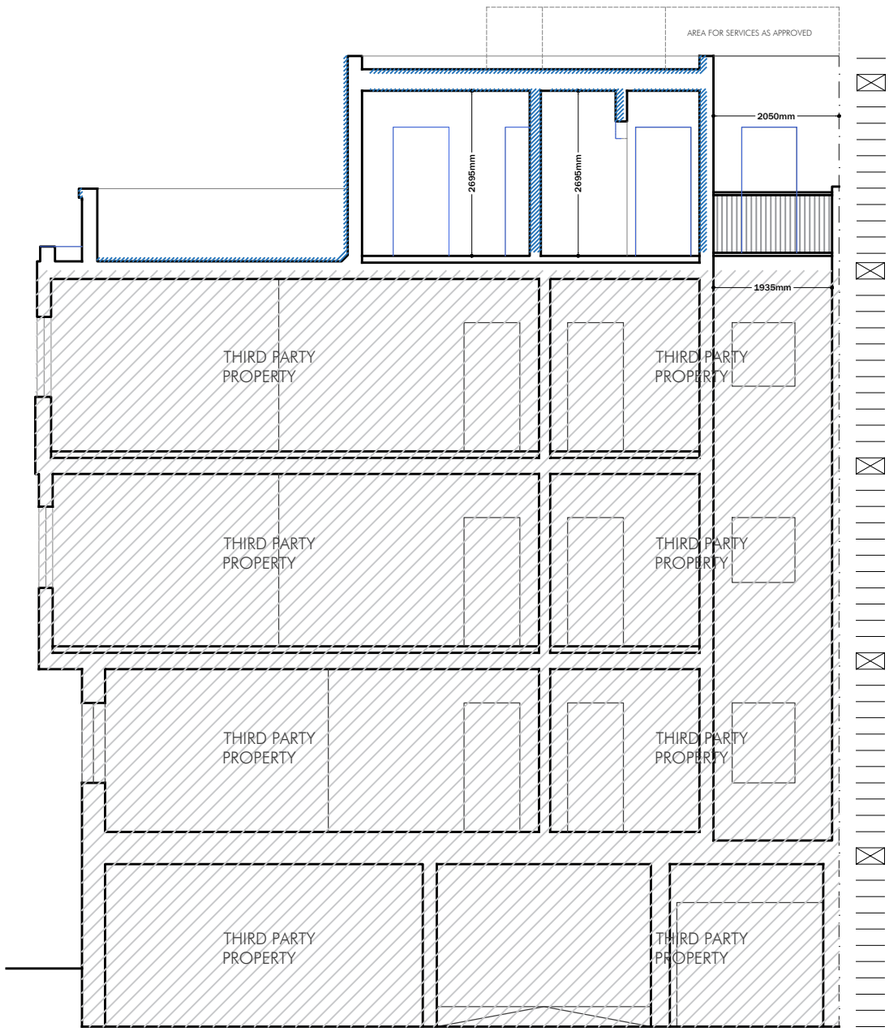

PROPOSED SECTION B-B'
SCALE: 1:100

30x30

ARCHITECTURE STUDIO

PERIT PAUL AQUILINA M: 79317366 E: info@30x30designstudio.com
PERIT ETIENNE SPITERI M: 99020795

PROJECT TITLE

10.09.2022

To sanction changes in existing receded floor level from approved l

DRAWING TITLE
SECTION B-B' DRAWING

DRAWN BY
ETIENNE SPITERI

SCALE/S
1:100

SHEET
A2

DRAWING REFERENCE
30X30_22_72_DWG05

PURPOSE OF DRAWING
PLANNING STAGE

REVISION OF DRAWING

REV 1 DATE:

REV 1 DATE:

REV 1 DATE:

REV 1 DATE:

REV 1 DATE:

TO DEMOLISH

TO CONSTRUCT

APPROVED / NOT CONSTRUCTED

AS BUILT / TO SANCTION

APPLICANT

LOCATION
HAD-DINGLI

FILE REFERENCE
30X30_22_72