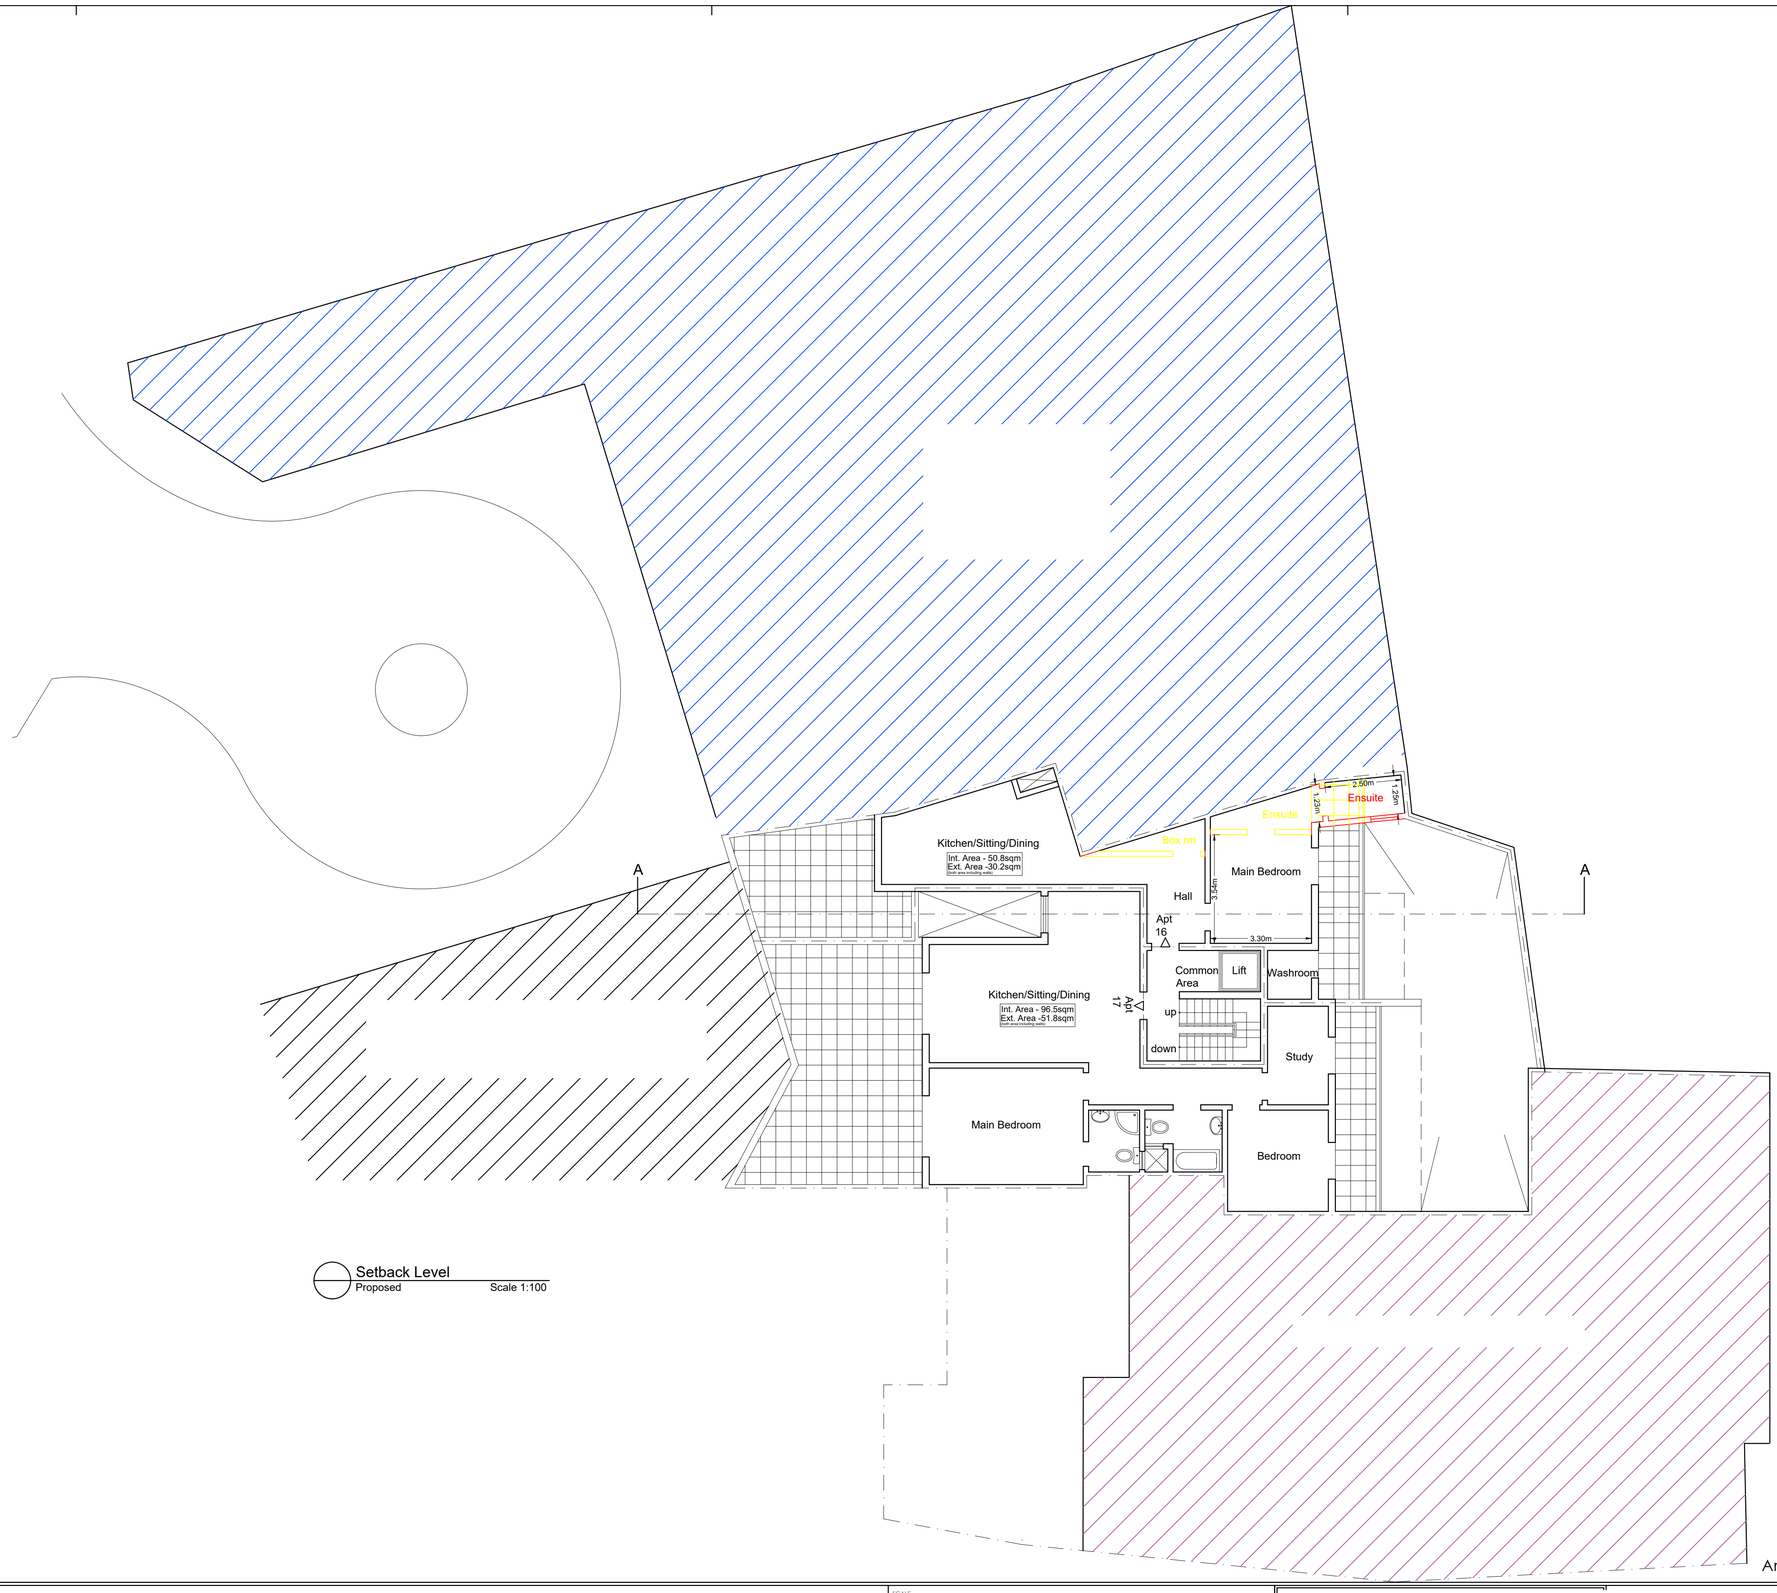


Setback Level
Proposed Scale 1:100

Amended 01.06.2026

NOTES: General

- To Demolish
- To Construct
- As Approved
- As Built

SCALE

1:100 0 1.00m 2.00m 3.00m 4.00m 5.00m 6.00m 7.00m 8.00m 9.00m
1:1000 0 10m 20m 30m 40m 50m 60m 70m 80m 90m 100m