0 1 2 4 6 8 10M

SCALE 1:100

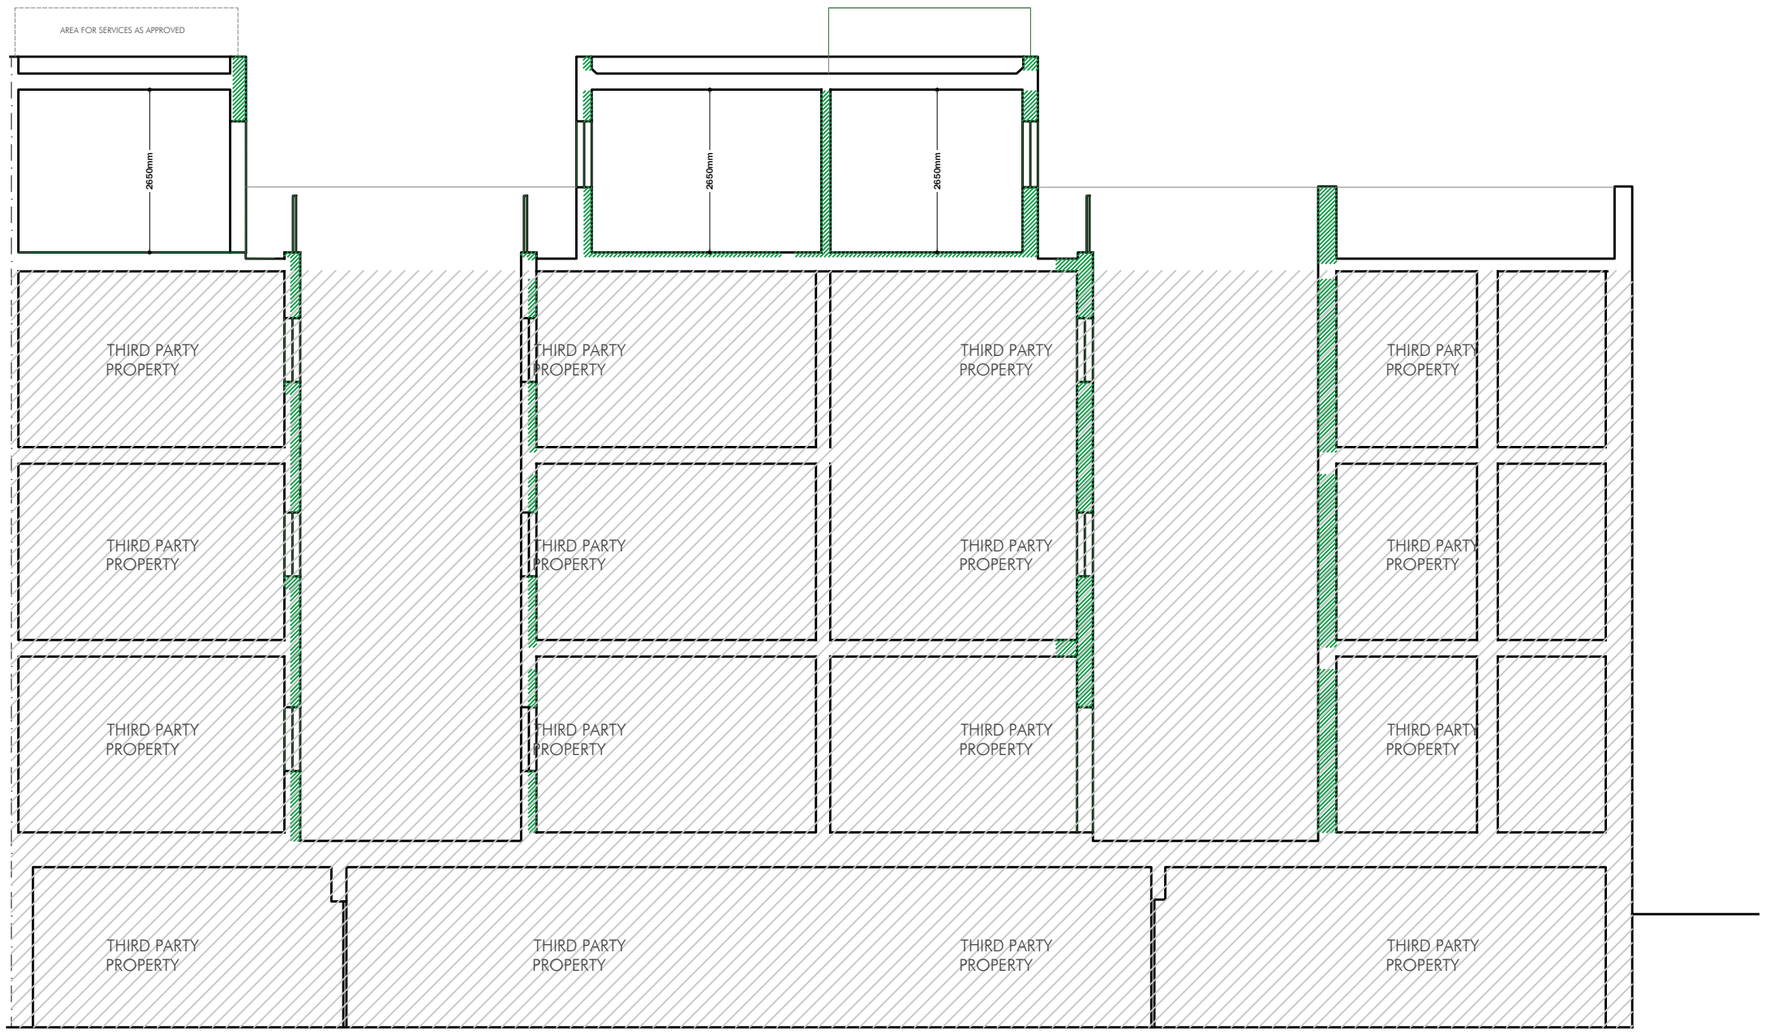

APPROVED SECTION A-A'
SCALE: 1:100

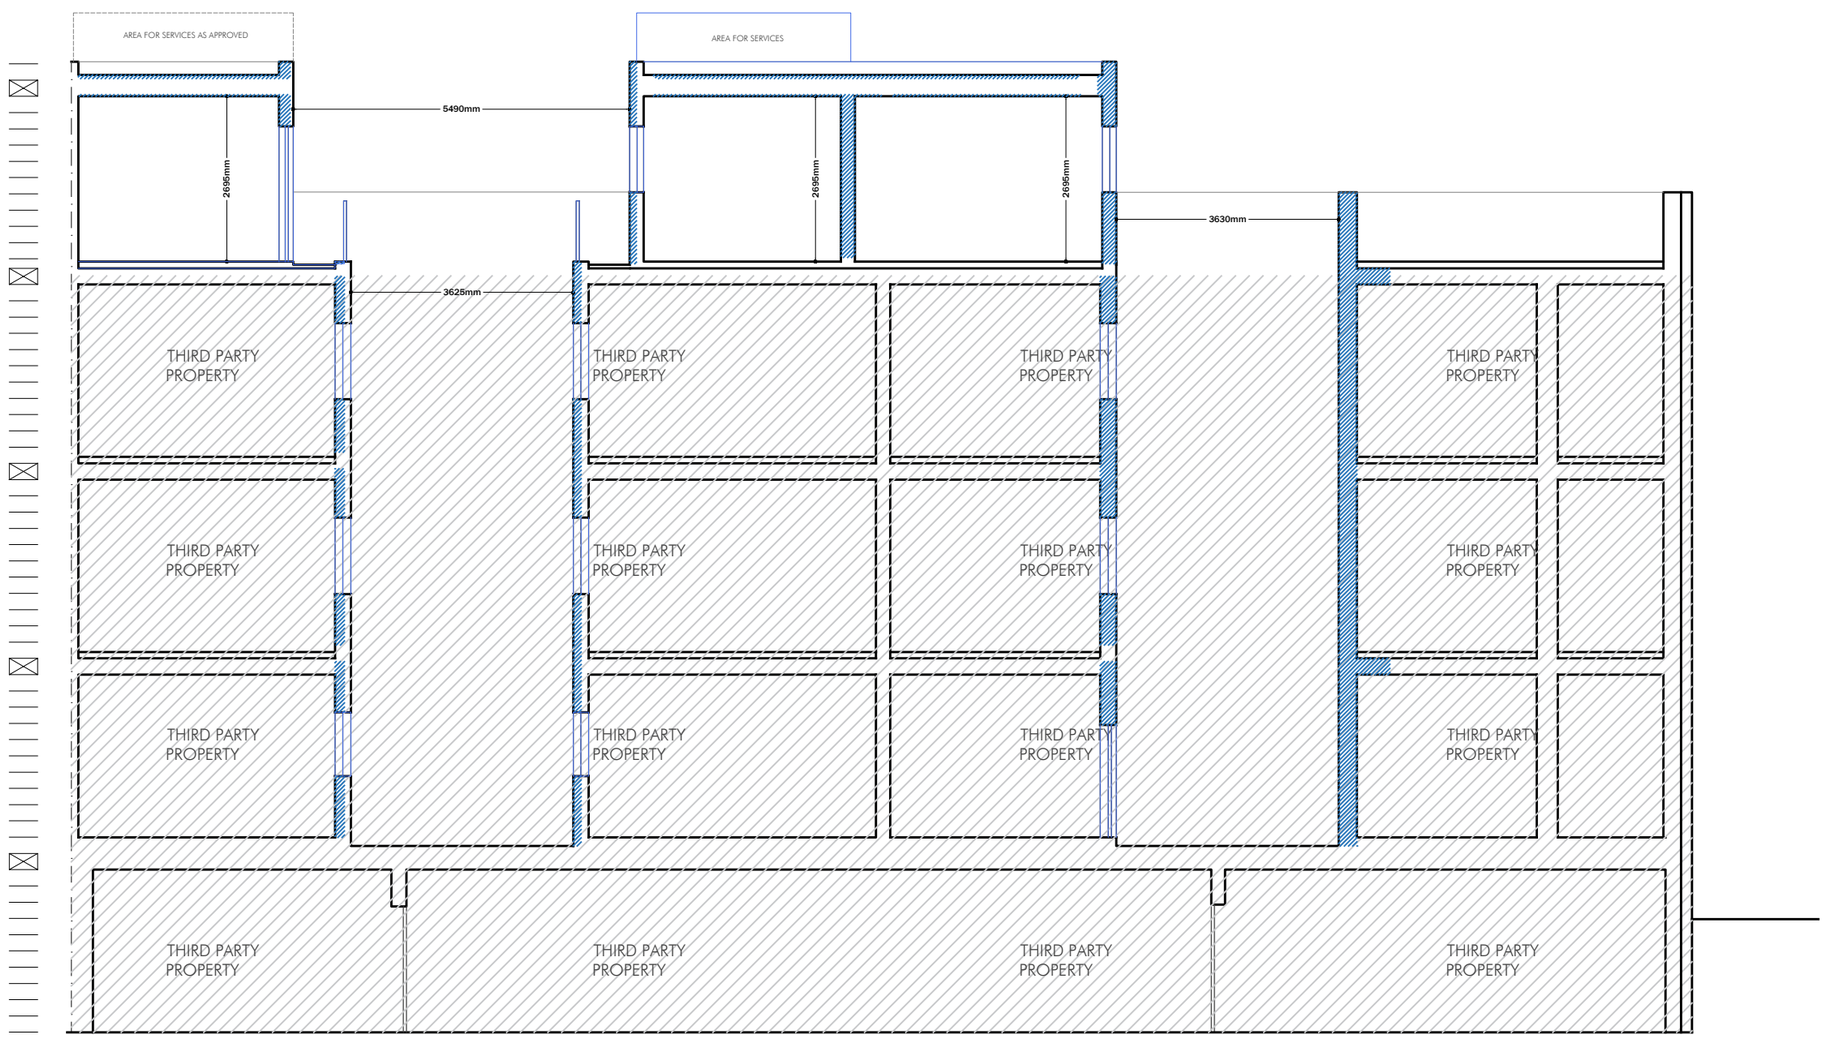

PROPOSED SECTION A-A'
SCALE: 1:100

30x30

ARCHITECTURE STUDIO

PERIT PAUL AQUILINA M: 79317366 E: info@30x30designstudio.com
PERIT ETIENNE SPITERI M: 99020795

PROJECT TITLE

10.09.2022

To sanction changes in existing receded floor level from approved

DRAWING TITLE
SECTION A-A' DRAWING

DRAWN BY
ETIENNE SPITERI

SCALE/S
1:100

SHEET
A2

DRAWING REFERENCE
30X30_22_72_DWG04

PURPOSE OF DRAWING
PLANNING STAGE

REVISION OF DRAWING
REV 1 DATE:
REV 1 DATE:
REV 1 DATE:
REV 1 DATE:
REV 1 DATE:

- TO DEMOLISH
- TO CONSTRUCT
- APPROVED / NOT CONSTRUCTED
- AS BUILT / TO SANCTION

APPLICANT

LOCATION
HAD-DINGLI

FILE REFERENCE
30X30_22_72