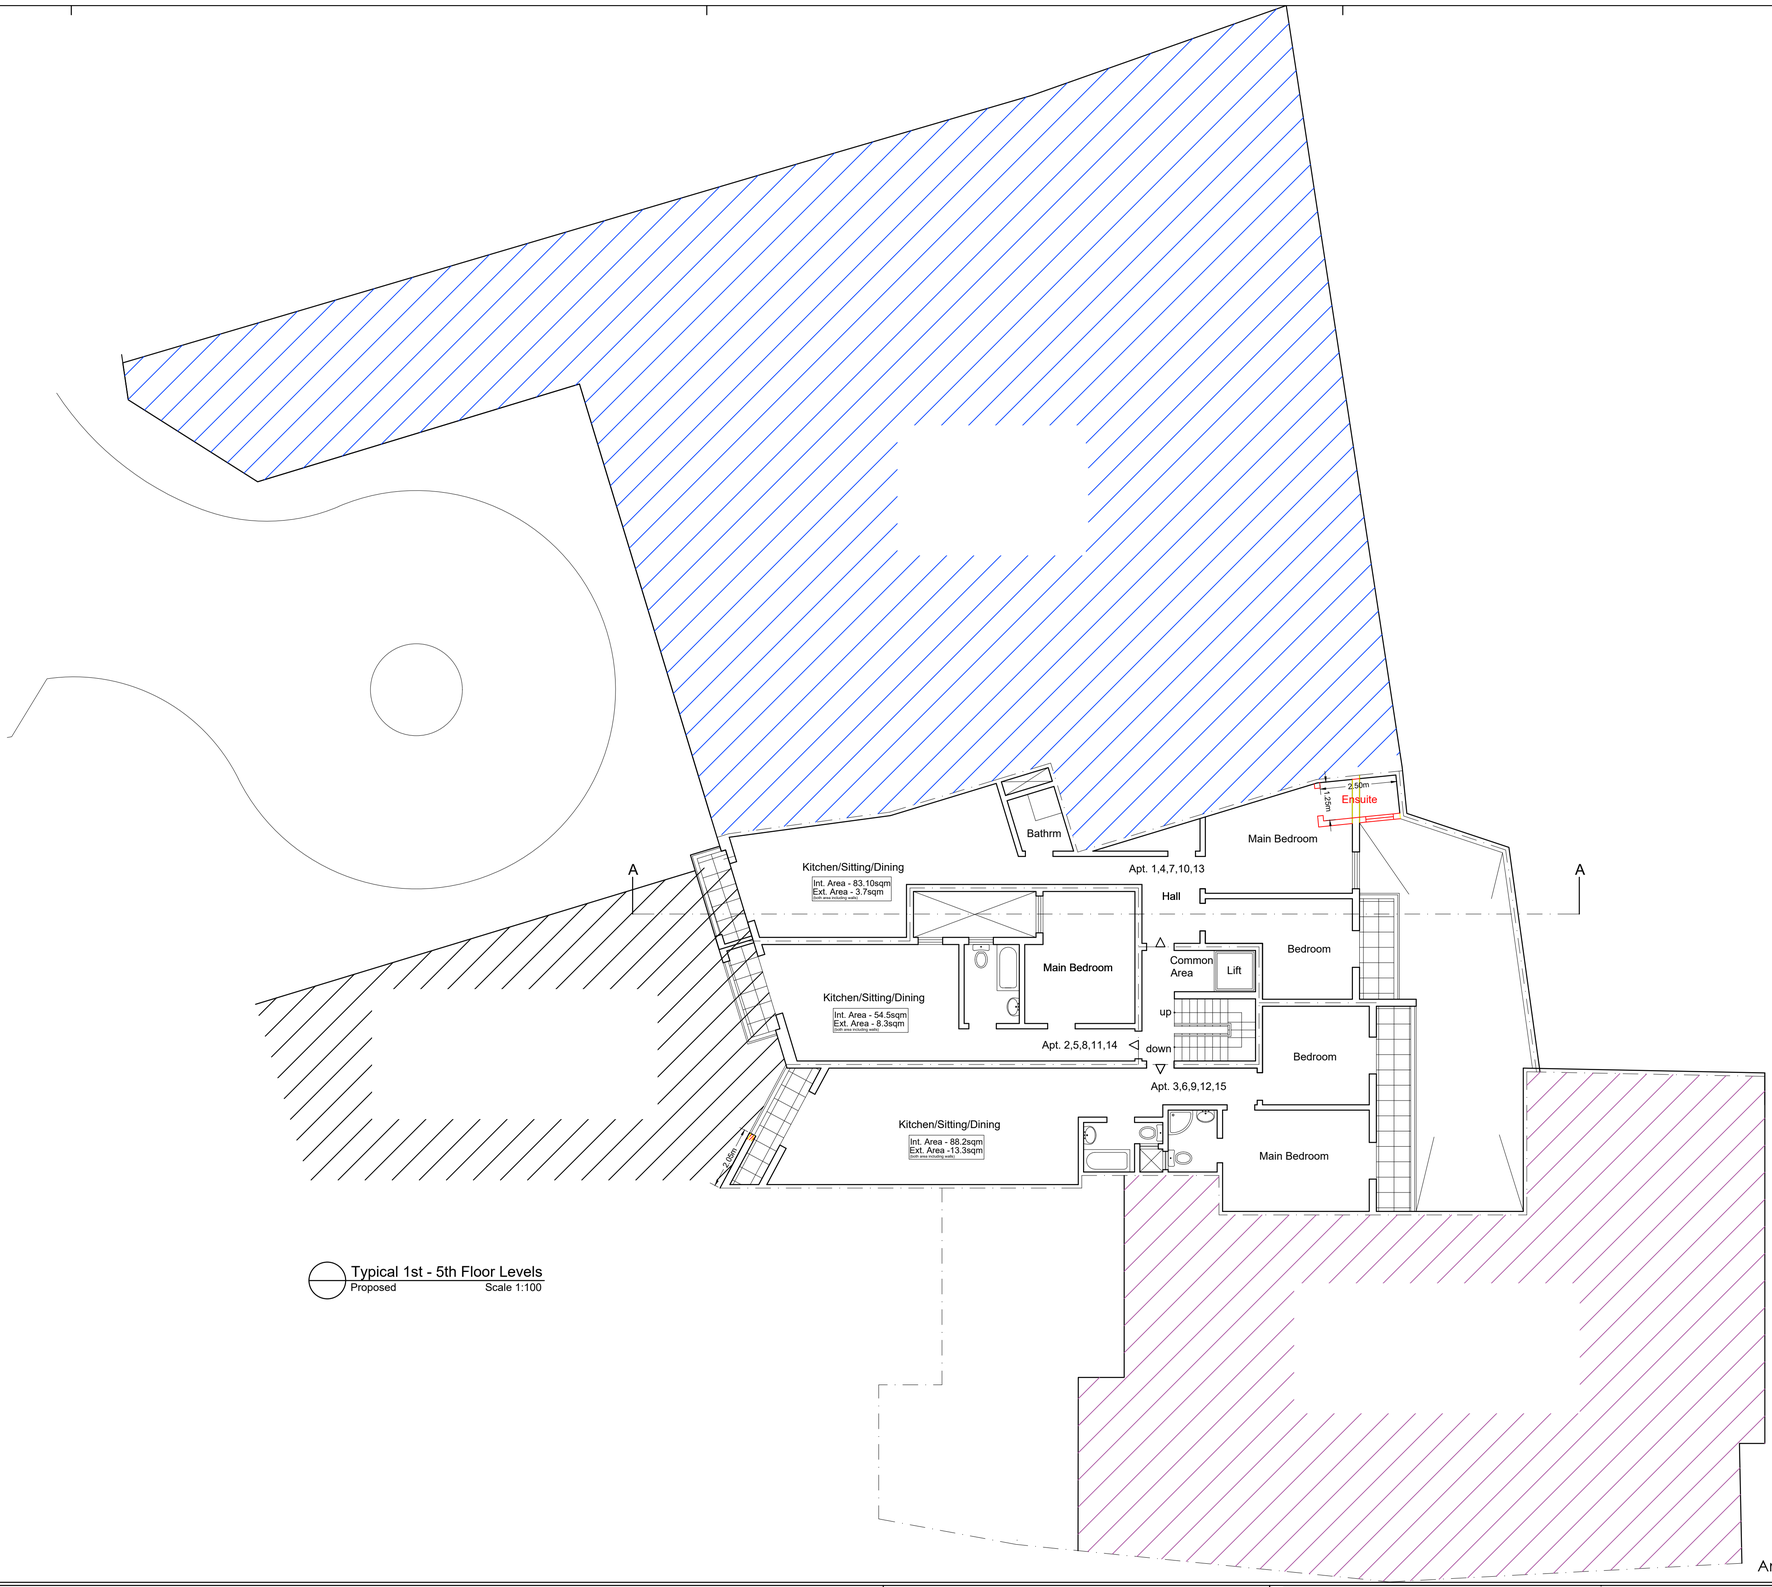

Typical 1st - 5th Floor Levels
Proposed Scale 1:100

Amended 01.06.2026

NOTES: General

- To Demolish
- To Construct
- As Approved
- As Built

SCALE

1:100 1:1000 0 1.00m 10m 2.00m 20m 3.00m 30m 4.00m 40m 5.00m 50m 6.00m 60m 7.00m 70m 8.00m 80m 9.00m 90m 10.00m 100m