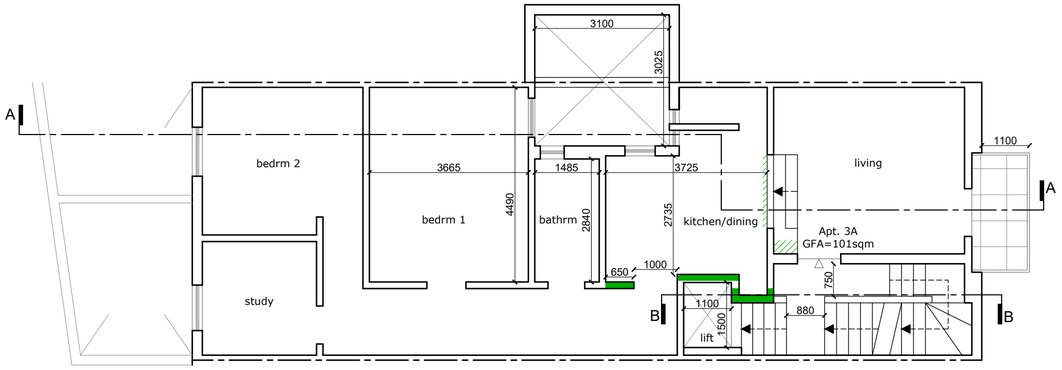

Approved second floor
Scale 1:100

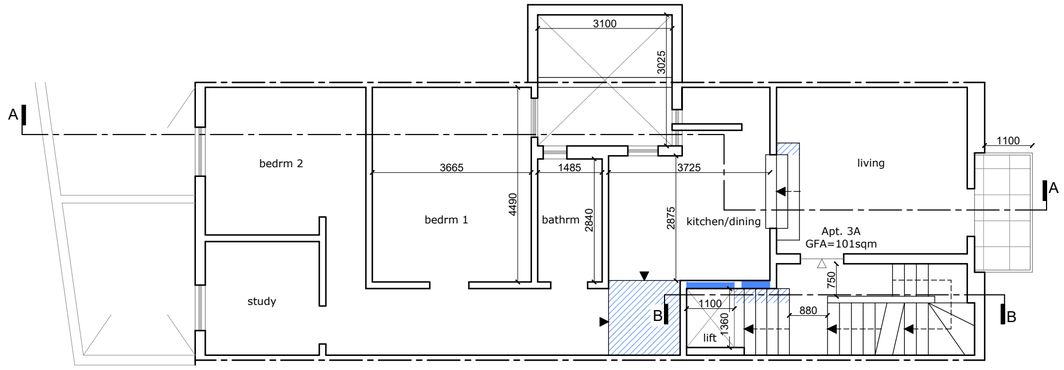

Existing second floor
Scale 1:100

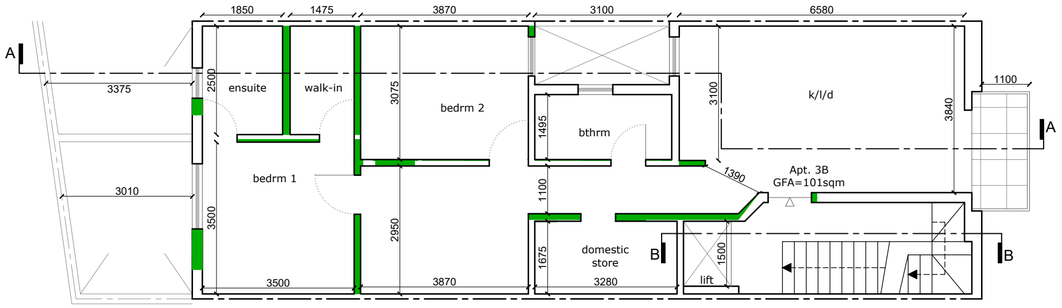

Approved third floor
Scale 1:100

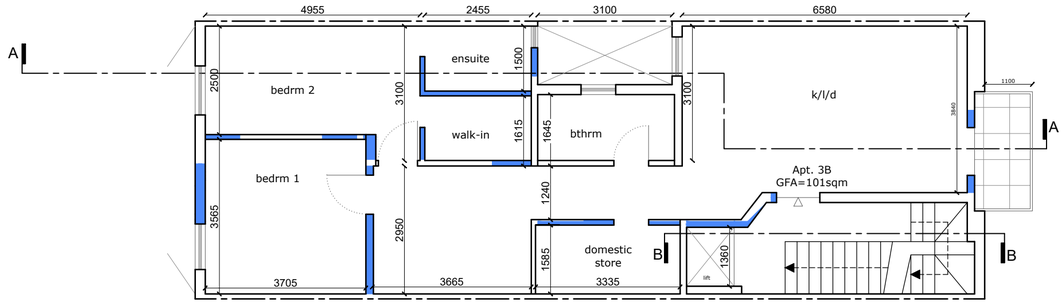

Existing third floor
Scale 1:100

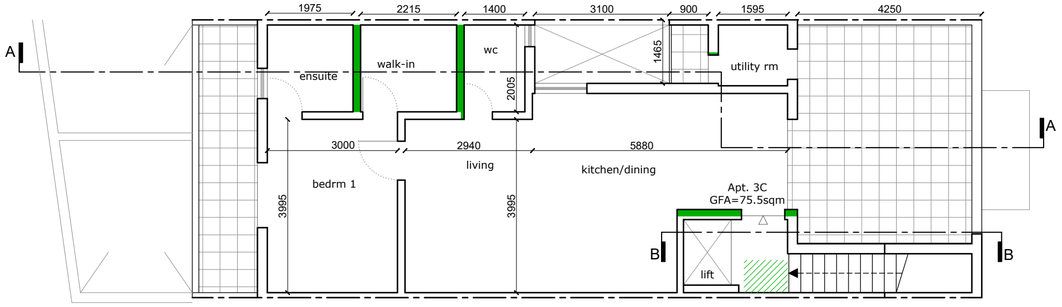

Approved setback floor
Scale 1:100

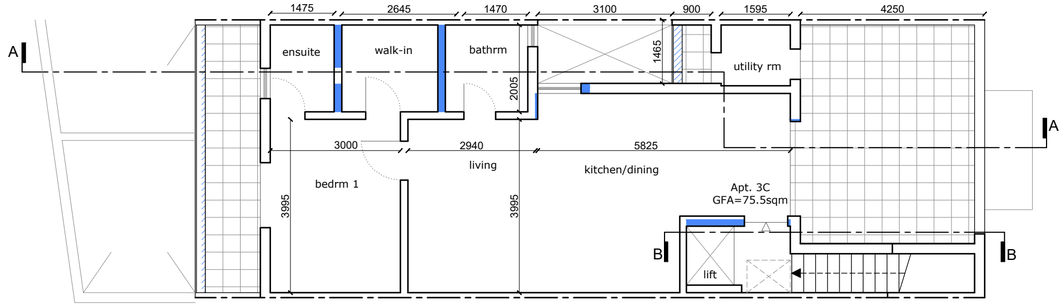

Existing setback floor
Scale 1:100

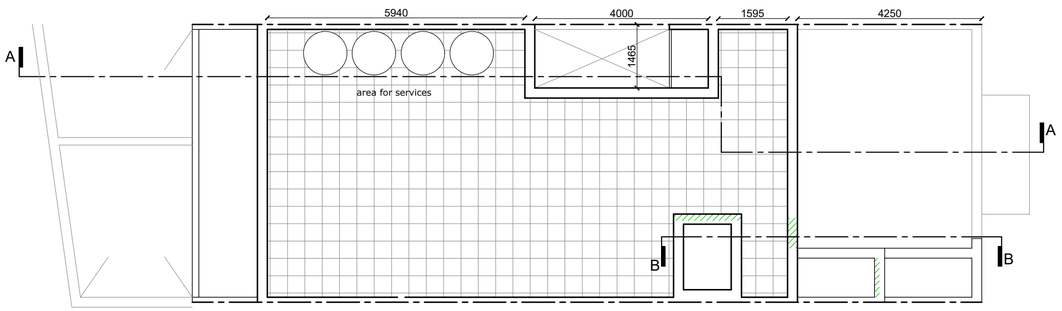

Approved setback roof with services
Scale 1:100

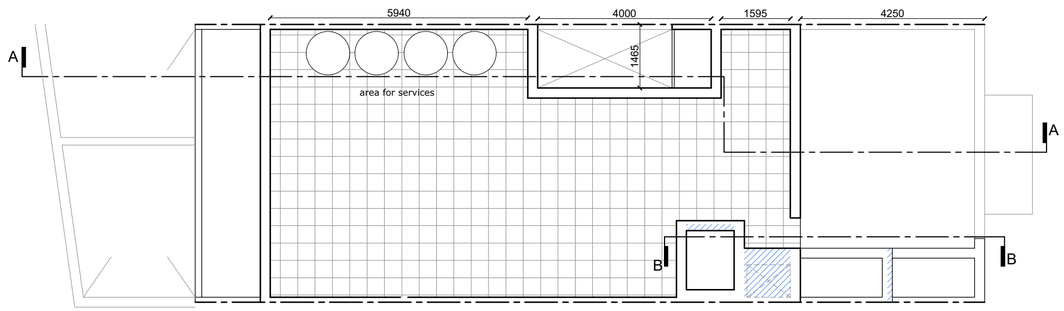

Existing setback roof with services
Scale 1:100

Scale 1:100 1 0 1 2 3 4 5 6 7 8 9 10 Mts.

N

To Construct
As built to sanction
To Demolish
As approved not constructed